

MISSISSIPPI DEPARTMENT OF NATURAL RESOURCES

Bureau of Land and Water Resources

Southport Mall

P.O. Box 10631

Jackson, Mississippi 39201

WATER WELL DRILLERS LOG

CODED

SUNFLOWER
L 75
7-30-81
7/30/81

date/well completed

firm name

county well located

Raywell & Sons Sunflower

LANDOWNER: Edward Bright

description of formations encountered

from

to

Indianola, MS
(mailing address)

Clay
Fine Sand
Sand
Sand + Gravel

0 28
28 34
34 40
40 113

WELL LOCATION:

sec. 7 T 200 (N) R. 3 (E) (W)
2 miles W of Blaine
(distance) (direction) (nearest town)

WELL PURPOSE:

(home, irrigation, municipal, industrial)

CODED


WELL COMPLETION DATA:

- (1) diameter (inches) 16
- (2) total depth (feet) 113'
- (3) static water level (feet) 21 below top of ground.
- (4) casing Steel 73'
(material) (depth)
16 if telescope see back.
(size)
- (5) screen 40' 73'
(length) (depth to top)
16 Steel
(size) (material)
- (6) pump 60 3000
(HP) (yield gpm)
Electric
(type power)
- (7) electric log No
(yes or no)

(organization running log)

(8) how well bottom plugged Plate

DRILLERS REMARKS:

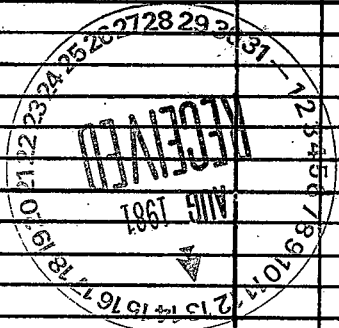

If well telescopes please sketch and show depths.

GROUND LEVEL

X			

SECTION 2

Please indicate well location X.

ADDITIONAL INFORMATION

If more than one screen, show locations of each on sketch.