

Sunflower
L-76
10/16/79

MISSISSIPPI
BOARD OF WATER COMMISSIONERS
416 North State Street
Jackson, Mississippi 39201

CODED

WATER WELL DRILLERS LOG

10/16/1979 date well completed
79 DYER WELL IRR firm name
SUNFLOWER county well located

LANDOWNER:
SAMMIE ROSE
SUNFLOWER
(mailing address)
WELL LOCATION:
sec. 33 T 20 N R 3 E
S W
2 miles E of SUNFLOWER
(distance) (direction) (nearest town)

description of formations encountered	from	to
Clay	0	28
fine sand	28	38
sand	38	48
sand & gravel	48	113

WELL PURPOSE:
(home, irrigation, municipal, industrial)

WELL COMPLETION DATA:
(1) diameter (inches) 16
(2) total depth (feet) 113
(3) static water level (feet) 20 below top of ground.
(4) casing STEEL 73
(material) (depth)
16 If telescope see back.
(size)
(5) screen 40 73
(length) (depth to top)
16 STEEL
(size) (material)
(6) pump 60 3000
(HP) (yield gpm)
DIESEL
(type power)
(7) electric log NO
(yes or no)

CODED

(organization running log)
(8) how well bottom plugged PLATE

DEPT. OF NATURAL RESOURCES
BUREAU OF LAND & WATER RESOURCES


DRILLERS REMARKS:

JAN 16 1980

RECEIVED

If well telescopes please sketch and show depths.

GROUND LEVEL

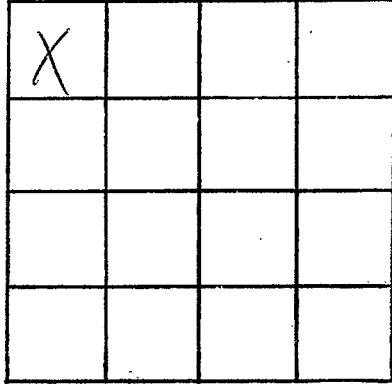

SECTION 33

Please indicate well location X.

ADDITIONAL INFORMATION

If more than one screen,
show locations of each on sketch.