

MISSISSIPPI DEPARTMENT OF NATURAL RESOURCES

Bureau of Land and Water Resources

Southport Mall

P.O. Box 10631

Jackson, Mississippi 39209

WATER WELL DRILLERS LOG

CODED

Sunflower
L 77
7-15-81

7-15-81 date well completed Dyer Well Drilling firm name Sunflower county well located

LANDOWNER:
J. H. Dodder

(mailing address)

WELL LOCATION:
sec. 12 T. 200 N. R. 3 E. S. 4 W.
2 4 miles WE of Blaine
(distance) (direction) (nearest town)

WELL PURPOSE:
(home, irrigation, municipal, industrial)

WELL COMPLETION DATA:

(1) diameter (inches) 16"

(2) total depth (feet) 110'

(3) static water level (feet) 22' below above top of ground.

(4) casing Steel 70'
(material) (depth)
16 if telescope see back.
(size)

(5) screen 40' 70'
(length) (depth to top)
16" Steel
(size) (material)

(6) pump 60 3000
(HP) (yield gpm)
Diesel
(type power)


(7) electric log no
(yes or no)

(organization running log)

(8) how well bottom plugged plate

description of formations encountered	from	to
<u>Clay</u>	<u>16</u>	<u>23</u>
<u>san</u>	<u>23</u>	<u>33</u>
<u>san</u>	<u>33</u>	<u>43</u>
<u>sand gravel</u>	<u>43</u>	<u>53</u>
<u>sand gravel</u>	<u>53</u>	<u>63</u>
<u>sand gravel</u>	<u>63</u>	<u>73</u>
<u>gravel</u>	<u>73</u>	<u>83</u>
<u>gravel</u>	<u>83</u>	<u>93</u>
<u>gravel</u>	<u>93</u>	<u>103</u>
<u>gravel</u>	<u>103</u>	<u>110</u>

CODED

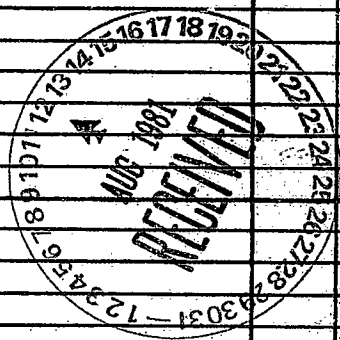

DRILLERS REMARKS:

If well telescopes please sketch and show depths.

GROUND LEVEL

X			

SECTION 12

Please indicate well location X.

ADDITIONAL INFORMATION

If more than one screen, show locations of each on sketch.