

MISSISSIPPI DEPARTMENT OF NATURAL RESOURCES

Bureau of Land and Water Resources

Southport Mall

P.O. Box 10631

Jackson, Mississippi 39209

WATER WELL DRILLERS LOG

CODED

Sunflower
L 79
7-10-81
7/10/81
 date/well completed

Raywell Drilling Service firm name
Sunflower county well located


LANDOWNER: Holly Ridge #3
Roberson Bros.
Holly Ridge, MS.
 (mailing address)

WELL LOCATION:
 sec. 12 T. 200 R. 3 E.
4 miles EW of Blaine
 (distance) (direction) (nearest town)

WELL PURPOSE:
 (home, irrigation, municipal, industrial)

WELL COMPLETION DATA:
 (1) diameter (inches) 16
 (2) total depth (feet) 113'
 (3) static water level (feet) 22' below top of ground.
 (4) casing Steel 73'
 (material) (depth)
16 If telescope see back.
 (size)
 (5) screen 40', 73'
 (length) (depth to top)
16, Steel
 (size) (material)
 (6) pump 240 2000
 (HP) (yield gpm)
Diesel
 (type power)
 (7) electric log No
 (yes or no)
 (organization running log)
 (8) how well bottom plugged Plate


| description of formations encountered | from | to |
|---------------------------------------|------------|------------|
| <u>Clay</u> | <u>13</u> | <u>23</u> |
| <u>Clay</u> | <u>23</u> | <u>33</u> |
| <u>sun</u> | <u>23</u> | <u>43</u> |
| <u>sand gravel</u> | <u>43</u> | <u>53</u> |
| <u>sand gravel</u> | <u>53</u> | <u>63</u> |
| <u>sun</u> | <u>63</u> | <u>73</u> |
| <u>gravel</u> | <u>73</u> | <u>83</u> |
| <u>clay</u> | <u>83</u> | <u>93</u> |
| <u>clay</u> | <u>93</u> | <u>103</u> |
| <u>clay</u> | <u>103</u> | <u>113</u> |

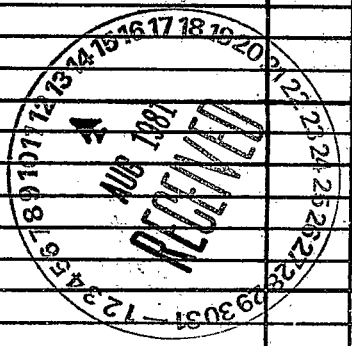

DRILLERS REMARKS:

If well telescopes please sketch and show depths.

GROUND LEVEL

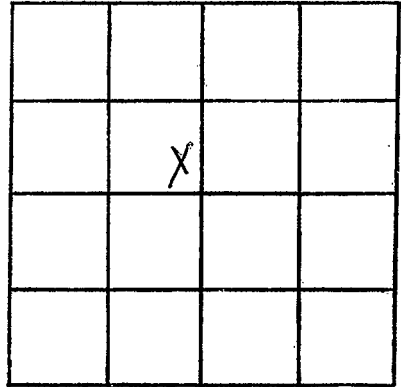

SECTION 12

Please indicate well location X.

ADDITIONAL INFORMATION

If more than one screen, show locations of each on sketch.