

MISSISSIPPI DEPARTMENT OF NATURAL RESOURCES

Bureau of Land and Water Resources

Southport Mall

P.O. Box 10631

Jackson, Mississippi 39209

WATER WELL DRILLERS

Sunflower
L 80
7/23/81

CODED

7/23/81 date well completed

Superwell Drilling firm name

Stumpkin county well located

LANDOWNER: Hoely Ridge

description of formations encountered

from

to

Indianola, MS.

(mailing address)

WELL LOCATION:

sec. 12 T 200 N R 3 E S W

? 4 miles WE of Blaine (distance) (direction) (nearest town)

C lay	0	28
Sand & Gravel	28	38
Fine Sand	38	38
Sand & Gravel	38	80
Fine Sand	80	90
Sand	90	66
Sand & Gravel	96	133

WELL PURPOSE:

(home, irrigation, municipal, industrial)

WELL COMPLETION DATA:

CODED

(1) diameter (inches) 16

(2) total depth (feet) 133'

(3) static water level (feet) 22' below top of ground.

(4) casing 40 Steel 93' (material) (depth)

16 (size) If telescope see back.

(5) screen 40 93' (length) (depth to top)

16 Steel (size) (material)


(6) pump 40 2000 (HP) (yield gpm)

diesel (type power)

(7) electric log No (yes or no)

(organization running log)


(8) how well bottom-plugged Plate

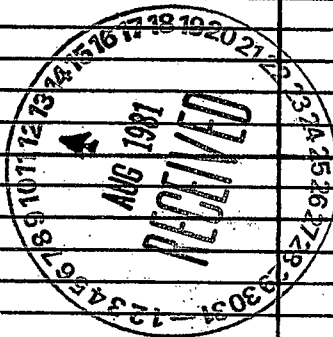

DRILLERS REMARKS:

If well telescopes please sketch and show depths.

GROUND LEVEL

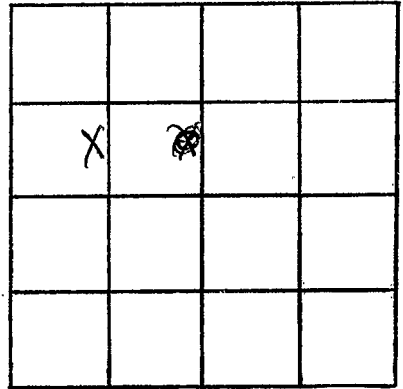

SECTION 12

Please indicate well location X.

ADDITIONAL INFORMATION

If more than one screen,
show locations of each on sketch.