

MISSISSIPPI DEPARTMENT OF NATURAL RESOURCES

Bureau of Land and Water Resources

Southport Mall

P.O. Box 10631

Jackson, Mississippi 39209

WATER WELL DRILLERS LOG

CODED

SUNFLOWER
L 81
8-23-80

08/23 1980 date well completed Larry's Well & Pump firm name Sunflower county well located

LANDOWNER: James Noleman  
 Daddsville, MS.  
 (mailing address)

description of formations encountered	from	to
clay	0	30
met sand	30	50
stone sand	50	70
course sandstone	70	114

WELL LOCATION:  
 sec. 10 T-20N R-3 E  
 3 miles East of Blaine  
 (distance) (direction) (nearest town)

WELL PURPOSE: Fish Pond  
 (home, irrigation, municipal, industrial)

- WELL COMPLETION DATA:
- (1) diameter (inches) 16"
  - (2) total depth (feet) 114'
  - (3) static water level (feet) 24' below top of ground
  - (4) casing Steel 74' (material) (depth)
  - (5) screen 40' 74' (length) (depth to top)  
 16" steel (size) (material)
  - (6) pump 60 3000 (HP) (yield gpm)
  - (7) electric log No (yes or no)
  - (8) how well bottom plugged steel plate

CODED

DEPT. OF NATURAL RESOURCES  
 BUREAU OF LAND & WATER RESOURCES


OCT 15 1980

RECEIVED

DRILLERS REMARKS:

If well telescopes please sketch and show depths.

GROUND LEVEL

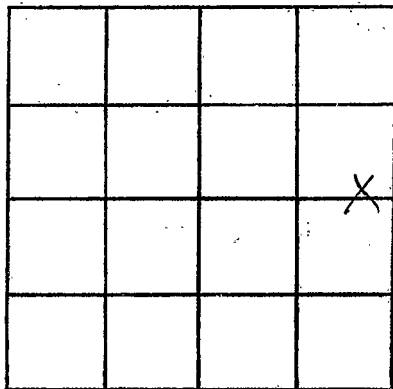

SECTION 10

Please indicate well location X.

ADDITIONAL INFORMATION

If more than one screen, show locations of each on sketch.