

MISSISSIPPI DEPARTMENT OF NATURAL RESOURCES

Bureau of Land and Water Resources

Southport Mall

P.O. Box 10631

Jackson, Mississippi 39209

WATER WELL DRILLERS LOG

CODED

SUNFLOWER
L 82
10/6/80

GW 6433

NE/NE, Sec. 8

Elev. 125

10/6/80 19 80
date well completed

Larry's well & pump
owner name

Sunflower
county well located

LANDOWNER: <u>James Holman</u>	description of formations encountered	from	to
<u>Doddsville ms</u> (mailing address)	<u>CLAY</u>	<u>0</u>	<u>30</u>
WELL LOCATION: sec. <u>8</u> T. <u>20</u> N. R. <u>3</u> W. <u>3</u> miles <u>N</u> of <u>Phineas</u> (distance) (direction) (nearest town)	<u>FINE SAND</u>	<u>30</u>	<u>60</u>
WELL PURPOSE: <u>Fish Pond</u> (home, irrigation, municipal, industrial)	<u>COURSE SAND</u>	<u>60</u>	<u>100</u>
WELL COMPLETION DATA:	CODED		
(1) diameter (inches) <u>12"</u>			
(2) total depth (feet) <u>108'</u>			
(3) static water level (feet) <u>26</u> below above top of ground.			
(4) casing <u>Steel</u> , <u>68'</u> , (material) (depth) (size) if telescope see back.			
(5) screen <u>40'</u> , <u>68'</u> (length) (depth to top)			
<u>12"</u> , <u>Steel</u> (size) (material)			
(6) pump <u>40</u> <u>2000</u> (HP) (yield gpm) (type power)			
(7) electric log <u>No</u> (yes or no) (organization running log)			
(8) how well bottom plugged <u>Steel Plate</u>			
DRILLERS REMARKS:			


DEPT. OF NATURAL RESOURCES
BUREAU OF LAND & WATER RESOURCES

OCT 15 1981

RECEIVED

If well telescopes please sketch and show depths.

GROUND LEVEL

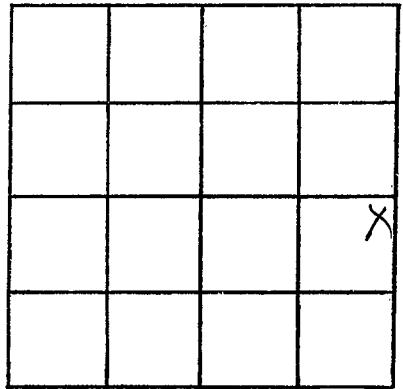

SECTION 5

Please indicate well location X.

ADDITIONAL INFORMATION

If more than one screen,
show locations of each on sketch.