

MISSISSIPPI DEPARTMENT OF NATURAL RESOURCES

Bureau of Land and Water Resources

Southport Mall

P.O. Box 10631

Jackson, Mississippi 39209

WATER WELL DRILLERS LOG

CODED

Sun Flower  
L83  
6-19-81

June 19, 1981 date well completed  
Larry's well & Pump firm name  
Sunflower county/well located

LANDOWNER: James Holeman	description of formations encountered	from	to
Doddsville, Mo (mailing address)	clay fine sand Coarse sand	0 28 56	28 56 106
<b>WELL LOCATION:</b> sec 5 T 20 N R 3 E 3 miles N of Plain (distance) (direction) (nearest town)			
<b>WELL PURPOSE:</b> Fish Pond (home, irrigation, municipal, industrial)			
<b>WELL COMPLETION DATA:</b>			
(1) diameter (inches) 12"			
(2) total depth (feet) 106'			
(3) static water level (feet) 23 below top of ground.			
(4) casing Steel, 66' (material) (depth)			
(size) If telescope see back.			
(5) screen 40', 66' (length) (depth to top)			
12", Steel (size) (material)			
(6) pump 40 2000 (HP) (yield gpm)			
(type power)			
(7) electric log No (yes or no)			
(organization running log)			
(8) how well bottom plugged Steel Plate			
DRILLERS REMARKS:			

CODED


DEPT. OF NATURAL RESOURCES  
BUREAU OF LAND & WATER RESOURCES

OCT 15 1981

RECEIVED

If well telescopes please sketch and show depths.

GROUND LEVEL

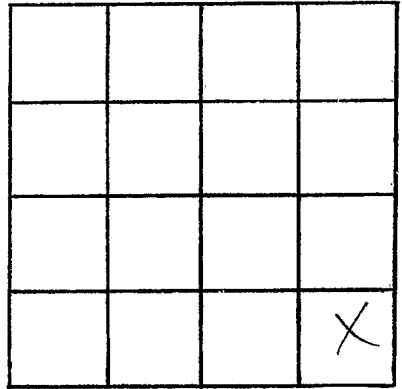

SECTION 5

Please indicate well location X.

ADDITIONAL INFORMATION

If more than one screen,  
show locations of each on sketch.