

MISSISSIPPI DEPARTMENT OF NATURAL RESOURCES

Bureau of Land and Water Resources

Southport Mall

P.O. Box 10631

Jackson, Mississippi 39209

WATER WELL DRILLERS LOG

CODED

Sunflower  
L 84  
4-16-81

date well completed April 16 1981 well name Larson's well & Pump county well located Sunflower

LANDOWNER: <u>Charles McClatchey</u>	description of formations encountered	from	to
<u>Indiawola ms</u> (mailing address)	<u>CLAY</u>	<u>0</u>	<u>40</u>
	<u>FINE SAND</u>	<u>40</u>	<u>75</u>
	<u>CORSE SAND</u>	<u>75</u>	<u>116</u>
<b>WELL LOCATION:</b>			
sec. <u>11</u> T <u>19</u> N R <u>3</u> <u>4</u> miles <u>E</u> of <u>Blaine</u> (distance) (direction) (nearest town)			
<b>WELL PURPOSE:</b> (home, irrigation, municipal, industrial)			
<b>WELL COMPLETION DATA:</b>			
(1) diameter (inches) <u>16"</u>			
(2) total depth (feet) <u>116'</u>			
(3) static water level (feet) <u>23</u> below above top of ground.			
(4) casing <u>Steel</u> , <u>76'</u> (material) (depth)			
(size) If telescope see back.			
(5) screen <u>16"</u> , <u>76'</u> (length) (depth to top)			
(size) <u>16"</u> , <u>Steel</u> (material)			
(6) pump <u>60</u> <u>3000</u> (HP) (yield gpm)			
(type power)			
(7) electric log <u>NO</u> (yes or no)			
(organization running log)			
(8) how well bottom plugged <u>Steel Plate</u>			
DRILLERS REMARKS:			

CODED


DEPT. OF NATURAL RESOURCES  
BUREAU OF LAND & WATER RESOURCES

OCT 19 1981

RECEIVED

If well telescopes please  
sketch and show depths.

GROUND LEVEL

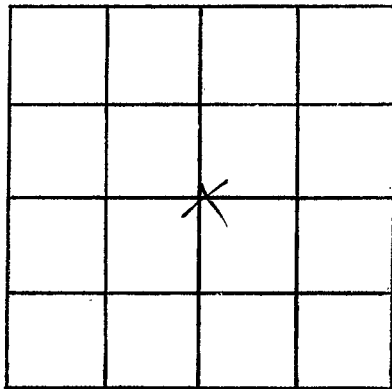

SECTION 11

Please indicate well location X.

ADDITIONAL INFORMATION

If more than one screen,  
show locations of each on sketch.