

MISSISSIPPI DEPARTMENT OF NATURAL RESOURCES

Bureau of Land and Water Resources

Southport Mall

P.O. Box 10631

Jackson, Mississippi 39209

WATER WELL DRILLERS LOG

Sunflower  
L85  
4-15-81

CODED

date well completed April 15 1981 firm name Larry's well & pump county well located Sunflower

LANDOWNER: Charles McClatchey

description of formations encountered	from	to
CLAY	0	40
FINE SAND	40	75
MED SAND & GRAVEL	75	100

Indianola  
 (mailing address)

WELL LOCATION:  
 sec. 4 T. 17 N. R. 3  
2 miles NE of Plain  
 (distance) (direction) (nearest town)

WELL PURPOSE:  
 (home, irrigation, municipal, industrial)

WELL COMPLETION DATA:

- (1) diameter (inches) 8"
- (2) total depth (feet) 100'
- (3) static water level (feet) 2.3 below above top of ground.
- (4) casing plastic, 60'  
 (material) (depth)  
 (size) if telescope see back.
- (5) screen 40', 60'  
 (length) (depth to top)  
8", Plastic  
 (size) (material)
- (6) pump 10, 700  
 (HP) (yield gpm)  
 (type power)
- (7) electric log NO  
 (yes or no)

CODED

(organization running log) Plastic  
 (8) how well bottom plugged back  
Plate

DEPT OF NATURAL RESOURCES  
 BUREAU OF LAND & WATER RESOURCES


OCT 19 1981

RECEIVED

DRILLERS REMARKS:

If well telescopes please sketch and show depths.

GROUND LEVEL

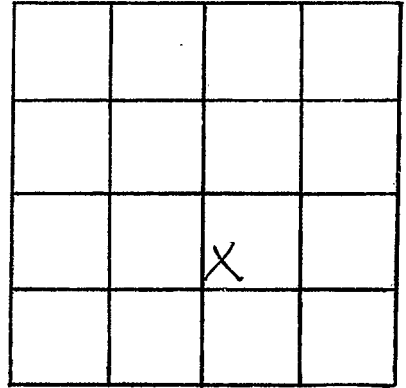

SECTION 4

Please indicate well location X.

ADDITIONAL INFORMATION

If more than one screen,  
show locations of each on sketch.