

MISSISSIPPI DEPARTMENT OF NATURAL RESOURCES

Bureau of Land and Water Resources

Southport Mall

P.O. Box 10631

Jackson, Mississippi 392

WATER WELL DRILLERS LOG

CODED

SUNFLOWER
L 88
8-6-81

USGS - 2088

8-6-1981
date well completed

81 Sun Well & Drilling
firm name

Sunflower
county well located

LANDOWNER:
Andy Bennett
Sunflower, MS.
(mailing address)

WELL LOCATION:
sec. 21 T 20 N R 3 E
3 miles NB of Sunflower
(distance) (direction) (nearest town)

WELL PURPOSE:
(home, irrigation, municipal, industrial)


WELL COMPLETION DATA:

- (1) diameter (inches) 16"
- (2) total depth (feet) 110'
- (3) static water level (feet) 22' below above top of ground.
- (4) casing Steel 70'
(material) (depth)
16" If telescope see back.
(size)
- (5) screen 40' 20'
(length) (depth to top)
16" Steel
(size) (material)
- (6) pump 40 2000
(HP) (yield gpm)
Electric
(type power)
- (7) electric log _____
(yes or no)

(organization running log)
- (8) how well bottom plugged plate

description of formations encountered	from	to
<u>Clay</u>	<u>13</u>	<u>23</u>
<u>Clay</u>	<u>23</u>	<u>33</u>
<u>Clay</u>	<u>33</u>	<u>43</u>
<u>clay shale</u>	<u>43</u>	<u>53</u>
<u>gravel</u>	<u>53</u>	<u>63</u>
<u>sand shale</u>	<u>63</u>	<u>73</u>
<u>gravel</u>	<u>73</u>	<u>83</u>
<u>gravel</u>	<u>83</u>	<u>93</u>
<u>sand gravel</u>	<u>93</u>	<u>103</u>
<u>gravel</u>	<u>103</u>	<u>110</u>

CODED

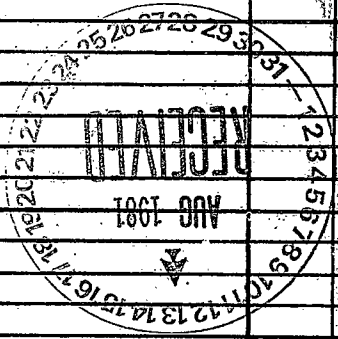


DRILLERS REMARKS:

[scribble]

If well telescopes please sketch and show depths.

GROUND LEVEL

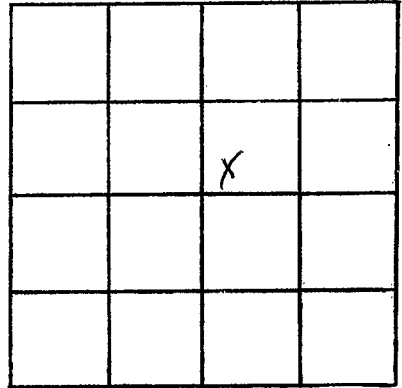

SECTION 27

Please indicate well location X.

ADDITIONAL INFORMATION

If more than one screen, show locations of each on sketch.