

Sunflower  
L 92  
3/20/82

MISSISSIPPI DEPARTMENT OF NATURAL RESOURCES  
 Bureau of Land and Water Resources  
 Southport Mall  
 P.O. Box 10631  
 Jackson, Mississippi 39209 **CODED**  
**WATER WELL DRILLERS LOG**

March 20 1982 Larry's Well & Pump Sunflower  
 date well completed firm name county/well located

LANDOWNER: I.E. Dattel  
Ruleville MS  
 (mailing address)

description of formations encountered	from	to
<u>clay</u>	<u>0</u>	<u>30</u>
<u>med sand</u>	<u>30</u>	<u>50</u>
<u>coarse sand</u>	<u>50</u>	<u>100</u>

WELL LOCATION:  
 sec 22 T 20 N R 3 E  
2 South miles 1/2 East of Blain  
 (distance) (direction) (nearest town)

WELL PURPOSE:  
 (home, irrigation, municipal, industrial)

WELL COMPLETION DATA:

- (1) diameter (inches) 8"
- (2) total depth (feet) 100-
- (3) static water level (feet) 29 below top of ground.
- (4) casing PVC 60'  
 (material) (depth)  
 (size) if telescope see back.
- (5) screen 40' 60'  
 (length) (depth to top)  
8" PVC  
 (size) (material)
- (6) pump 10 H.P 700  
 (HP) (yield gpm)  
Elec  
 (type power)
- (7) electric log NO  
 (yes or no)  
 (organization running log)
- (8) how well bottom plugged PVC  
cap

DRILLERS REMARKS:


DEPT. OF NATURAL RESOURCES  
 BUREAU OF LAND & WATER RESOURCES

JUN 21 1982

RECEIVED

If well telescopes please sketch and show depths.

GROUND LEVEL

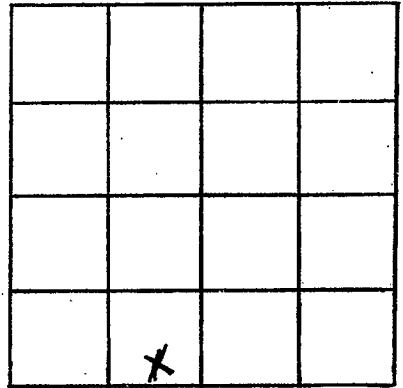

SECTION 22

Please indicate well location X.

ADDITIONAL INFORMATION

If more than one screen,  
show locations of each on sketch.