

**MISSISSIPPI DEPARTMENT OF NATURAL RESOURCES**  
**Bureau of Land and Water Resources**  
 Southport Mall  
 P.O. Box 10631  
 Jackson, Mississippi 39209  
**WATER WELL DRILLERS LOG**

**CODED**

Sunflower  
L 94  
4/1/82

4-1 1982 Deep Well Sunflower  
 date well completed firm name county/well located

LANDOWNER: Morgan  
 (mailing address)

description of formations encountered	from	to
<u>Clay</u>	<u>0</u>	<u>45</u>
<u>Sand + Gravel</u>	<u>45</u>	<u>108</u>

WELL LOCATION:  
 sec. 36 T 20 N R. 3 E  
4 miles NE of Sunflower  
 (distance) (direction) (nearest town)

WELL PURPOSE:  
 (home, irrigation, municipal, industrial)


- WELL COMPLETION DATA:
- (1) diameter (inches) 16
  - (2) total depth (feet) 108
  - (3) static water level (feet) 15 below above top of ground.
  - (4) casing Steel, 68,  
 (material) (depth)  
14 if telescope see back.  
 (size)
  - (5) screen 46, 68  
 (length) (depth to top)  
16, mild steel  
 (size) (material)
  - (6) pump 60 3000  
 (HP) (yield gpm)  
diesel  
 (type power)
  - (7) electric log NO  
 (yes or no)
  - (organization running log)
  - (8) how well bottom plugged Plate

DRILLERS REMARKS:

DEPT. OF NATURAL RESOURCES  
 BUREAU OF LAND AND WATER RESOURCES  
 SEP 30 1982  
**RECEIVED**

If well telescopes please sketch and show depths.

GROUND LEVEL

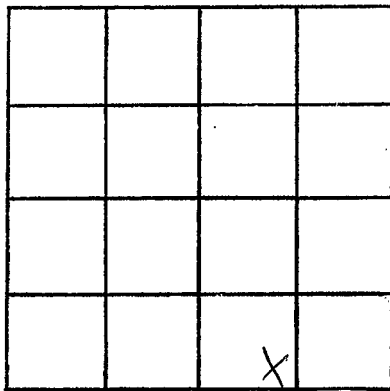

SECTION 36

Please indicate well location X.

ADDITIONAL INFORMATION

If more than one screen,  
show locations of each on sketch.