

MISSISSIPPI DEPARTMENT OF NATURAL RESOURCES
Bureau of Land and Water Resources

Southport Mall
P.O. Box 10631

CODED 1

Jackson, Mississippi 39209
WATER WELL DRILLERS LOG

L98
SUNFLOWER
Gw 4728

19 1984 date well completed J + K Irrigation + Well Sunflower firm name Sunflower county well located

LANDOWNER:
Milton Jeffco
Sunflower, Miss.
(mailing address)

description of formations encountered	from	to
<u>CLAY</u>	<u>0</u>	<u>59</u>
<u>STR and Gravel</u>	<u>59</u>	<u>103</u>

WELL LOCATION:
sec. 19 T 20 N R 3 E
S W
3 miles N of Sunflower
(distance) (direction) (nearest town)

WELL PURPOSE:
(home, irrigation, municipal, industrial)

WELL COMPLETION DATA:

(1) diameter (inches) 8

(2) total depth (feet) 103

(3) static water level (feet) 29 below above top of ground.

(4) casing PVC, 63,
(material) (depth)
8 if telescope see back.
(size)

(5) screen 140, 63
(length) (depth to top)
8, PVC
(size) (material)

(6) pump 10, 600
(HP) (yield gpm)
electric
(type power)

(7) electric log no
(yes or no)
(organization running log)

(8) how well bottom plugged cap

DEPT. OF NATURAL RESOURCES
BUREAU OF LAND & WATER RESOURCES


MAY 31 1984

RECEIVED

DRILLERS REMARKS:

If well telescopes please sketch and show depths.

GROUND LEVEL

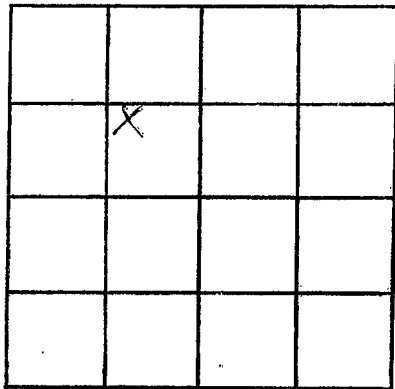

SECTION 19

Please indicate well location X.

ADDITIONAL INFORMATION

Lined area for additional information.

If more than one screen, show locations of each on sketch.