

MISSISSIPPI DEPARTMENT OF NATURAL RESOURCES

Bureau of Land and Water Resources

Southport Mall

P.O. Box 10631

Jackson, Mississippi 39209

WATER WELL DRILLERS LOG

CODER

SUNFLOWER
L 104

3-11-86
 date well completed

Ray's Pumpwell
 firm name

SUNFLOWER
 county well located

LANDOWNER: Dickensfield Farms
P.O. Box 926
Aberdeen, Miss
 (mailing address) 39730

Description of formations encountered	from	to
<u>clay</u>	<u>0</u>	<u>25</u>
<u>fine sand</u>	<u>25</u>	<u>45</u>
<u>coarse sand/pea gravel</u>	<u>45</u>	<u>105</u>

WELL LOCATION:

sec. 33 T. 20 N. R. 3 E.
3 miles NE of Sumner
 (distance) (direction) (nearest town)


WELL PURPOSE: Fish Pond
 (home, irrigation, municipal, industrial)

WELL COMPLETION DATA:

- (1) diameter (inches) 16"
- (2) total depth (feet) 105
- (3) static water level (feet) _____ below/above top of ground.
- (4) casing STEEL, 65'
 (material) (depth)
16" If telescope see back.
 (size)
- (5) screen 40', 65'
 (length) (depth to top)
16", STEEL
 (size) (material)
- (6) pump 50 3000
 (HP) (yield gpm)
E
 (type power)
- (7) electric log NO
 (yes or no)

(organization running log) STEEL
 (8) how well bottom plugged PLATE


DRILLERS REMARKS:

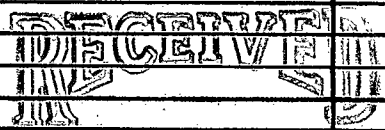

Department of Natural Resources
 Bureau of Land & Water Resources

If well telescopes please sketch and show depths.

GROUND LEVEL

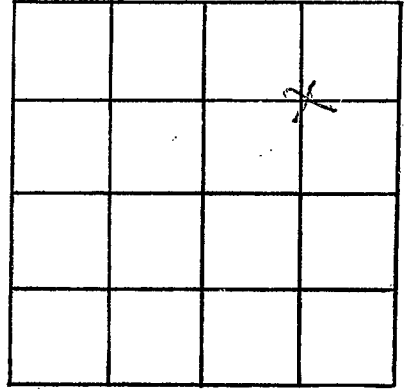

SECTION _____

Please indicate well location X.

ADDITIONAL INFORMATION

If more than one screen,
show locations of each on sketch.