

MISSISSIPPI DEPARTMENT OF NATURAL RESOURCES

Bureau of Land and Water Resources

Southport Mall

P.O. Box 10631

Jackson, Mississippi 39209

WATER WELL DRILLERS LOG

CODED

SUNFLOWER
L 105

3-25-86  
date well completed

19

Loyd Lumb Drilling Co. Sunflower  
firm name county well located

LANDOWNER: Diversified Farms

P.O. Box 926

Abbeville Miss  
(mailing address) 39230

description of formations encountered

from

to

clay	0	25
fine sand	25	40
coarse sand / peagravel	40	107

WELL LOCATION:


sec 33 T 20 N R 3 E  
S W  
3 miles NE of Sunflower  
(distance) (direction) (nearest town)

WELL PURPOSE: Fish Pond  
(home, irrigation, municipal, industrial)

WELL COMPLETION DATA:

- (1) diameter (inches) 16"
- (2) total depth (feet) 107
- (3) static water level (feet) \_\_\_\_\_ below above top of ground.
- (4) casing steel 67'  
(material) (depth)  
16" if telescope see back.  
(size)
- (5) screen 40 67'  
(length) (depth to top)  
16" STEEL  
(size) (material)
- (6) pump 50 3200  
(HP) (yield gpm)  
E  
(type power)
- (7) electric log NO  
(yes or no)  
(organization running log) STEEL
- (8) how well bottom plugged PLATE

CODED

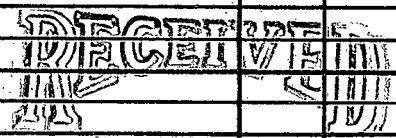


DRILLERS REMARKS:

Department of Natural Resources  
Bureau of Land and Water Resources

If well telescopes please sketch and show depths.

GROUND LEVEL

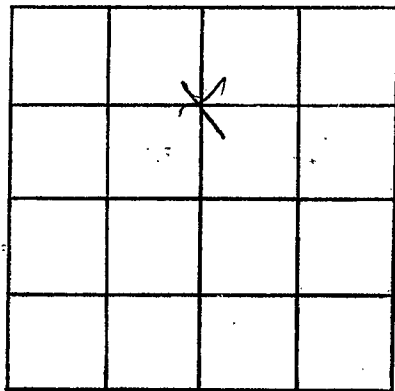

SECTION \_\_\_\_\_

Please indicate well location X.

ADDITIONAL INFORMATION

If more than one screen,  
show locations of each on sketch.