

MISSISSIPPI DEPARTMENT OF NATURAL RESOURCES

Bureau of Land and Water Resources

Southport Mall

P.O. Box 10631

Jackson, Mississippi 39209

WATER WELL DRILLERS LOG

CODED

SUNFLOWER
L 106

19 1985 date well completed Ray Stumpwell Co firm name SUNFLOWER county well located

LANDOWNER: <u>Dwight Steel Farms</u>	Description of formations encountered	from	to
<u>P.O. Box 926</u>	<u>clay</u>	<u>0</u>	<u>30</u>
<u>Abbeville Miss</u>	<u>fine sand</u>	<u>30</u>	<u>40</u>
(mailing address) <u>39730</u>	<u>Coarse sand/pea gravel</u>	<u>40</u>	<u>100</u>

WELL LOCATION:
sec. 28 T. 20 N. R. 3 E.
4 miles NE of Ray
(distance) (direction) (nearest town)

WELL PURPOSE: test bond
(home, irrigation, municipal, industrial)

- WELL COMPLETION DATA:
- (1) diameter (inches) 16"
 - (2) total depth (feet) 100
 - (3) static water level (feet) _____ below above top of ground.
 - (4) casing steel 60'
(material) (depth)
16" if telescope see back.
(size)
 - (5) screen 40' 60'
(length) (depth to top)
16" steel
(size) (material)
 - (6) pump 50 3000
(HP) (yield gpm)
E
(type power)
 - (7) electric log no
(yes or no)

(organization running log) Steel plate

(8) how well bottom plugged plate

DRILLERS REMARKS:


CODED

RECEIVED
AUG 26 1986

Department of Natural Resources
Bureau of Land and Water Resources

If well telescopes please sketch and show depths.

GROUND LEVEL

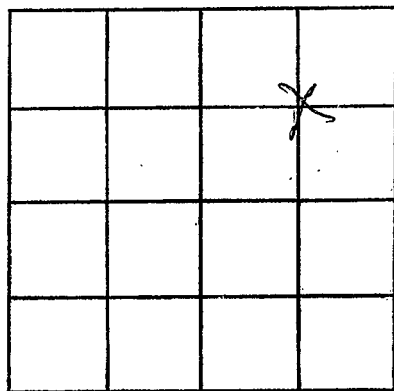

SECTION _____

Please indicate well location X.

ADDITIONAL INFORMATION

If more than one screen,
show locations of each on sketch.