

MISSISSIPPI DEPARTMENT OF NATURAL RESOURCES

Bureau of Land and Water Resources

Southport Mall

P.O. Box 10631


Jackson, Mississippi 39209

WATER WELL DRILLERS LOG

SUNFLOWER
L 107

date well completed 19 Sept 28 firm name Sunflower county well located _____

LANDOWNER: <u>Dina Steel Farm</u>	description of formations encountered		from	to
<u>P.O. Box 926</u>	<u>Clay</u>		<u>0</u>	<u>30</u>
<u>Meridian, Miss</u> (mailing address) <u>39130</u>	<u>Fine sand</u>		<u>30</u>	<u>40</u>
	<u>Coarse sand/pea gravel</u>		<u>40</u>	<u>100</u>
WELL LOCATION:				
sec <u>28</u> T <u>20</u> N R <u>3</u> E				
S W				
<u>4</u> miles <u>NE</u> of <u>Sunflower</u>				
(distance) (direction) (nearest town)				
WELL PURPOSE: <u>past land</u>				
(home, irrigation, municipal, industrial)				
WELL COMPLETION DATA:				
(1) diameter (inches) <u>16"</u>				
(2) total depth (feet) <u>100</u>				
(3) static water level (feet) _____ below/above top of ground.				
(4) casing <u>Steel</u> <u>60</u>				
(material) (depth)				
<u>16"</u> If telescope see back.				
(size)				
(5) screen <u>48'</u> <u>60'</u>				
(length) (depth to top)				
<u>16"</u> <u>Steel</u>				
(size) (material)				
(6) pump <u>50</u> <u>3000</u>				
(HP) (yield gpm)				
<u>E</u>				
(type power)				
(7) electric log <u>NO</u>				
(yes or no)				
(organization running log)				
(8) how well bottom plugged <u>Steel plate</u>				

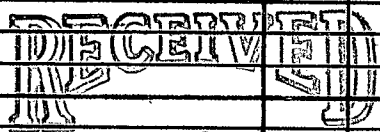


AUG 28 1986

Department of Natural Resources
 Bureau of Land & Water Resources

DRILLERS REMARKS: _____

If well telescopes please
sketch and show depths.

GROUND LEVEL

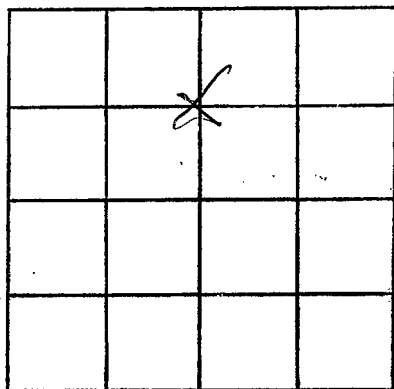

SECTION _____

Please indicate well location X.

ADDITIONAL INFORMATION

If more than one screen,
show locations of each on sketch.