

MISSISSIPPI DEPARTMENT OF NATURAL RESOURCES

Bureau of Land and Water Resources

Southport Mall

P.O. Box 10631

Jackson, Mississippi 39209

WATER WELL DRILLERS LOG

CODED

SUNFLOWER
L 108
86-213 CMG-01

8-2 1986 DYER Well, Inc. Sunflower
 date well completed firm name county well located

LANDOWNER: Holly Ridge Hg Co

description of formations encountered	from	to
	<u>Clay</u> <u>Sand & gravel</u>	<u>0</u> <u>36</u>

Jackson, Miss.
 (mailing address)


WELL LOCATION:
 sec. 12 T 20 N S R 3 E of SW 1/4
7 miles N.E. of Sunflower
 (distance) (direction) (nearest town)

WELL PURPOSE: Lubrication
 (home, irrigation, municipal, industrial)

WELL COMPLETION DATA:

- (1) diameter (inches) 16
- (2) total depth (feet) 98
- (3) static water level (feet) 24 below above top of ground.
- (4) casing Steel, 58
 (material) (depth)
16" if telescope see back.
 (size)
- (5) screen 40', 58
 (length) (depth to top)
16", Mild Steel
 (size) (material)
- (6) pump 30, 1500
 (HP) (yield gpm)
Electric
 (type power)
- (7) electric log No
 (yes or no)
- (organization running log)
- (8) how well bottom plugged Platc

CODED

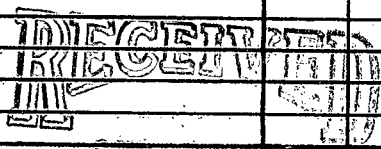


SEP 17 1986

Department of Natural Resources
 Bureau of Land & Water Resources

DRILLERS REMARKS:
86 213 - CMG - 01

If well telescopes please sketch and show depths.

GROUND LEVEL

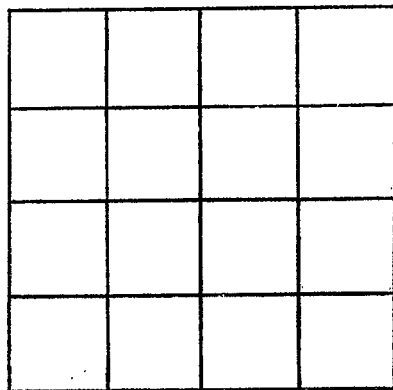

SECTION _____

Please indicate well location X.

ADDITIONAL INFORMATION

If more than one screen,
show locations of each on sketch.