

MISSISSIPPI DEPARTMENT OF NATURAL RESOURCES

Bureau of Land and Water Resources

Southport Mall

P.O. Box 10631

Jackson, Mississippi 39209

WATER WELL DRILLERS LOG

CODED

SUNFLOWER
L 109
86260 MGS-01

Sept 18 19 86
date well completed

Dyer Well, Inc
firm name

Sunflower
county well located

LANDOWNER:
Holly Ridge Ptz Co
Holly Ridge, Miss.
(mailing address)

description of formations encountered

from

to

Clay	0	30
Sand	30	40
Sand + Gravel	40	100

WELL LOCATION:

sec. 12 T 26 N R 3 E
S W
Blaine
miles (distance) of (direction) (nearest town)

CODED

WELL PURPOSE: Domestic
(home, irrigation, municipal, industrial)

WELL COMPLETION DATA:

- (1) diameter (inches) 16
- (2) total depth (feet) 100
- (3) static water level (feet) _____ below above top of ground.
- (4) casing Steel 70
(material) (depth)
16 if telescope see back.
(size)
- (5) screen 30
(length) (depth to top)
16, Mild Steel
(size) (material)
- (6) pump 30 1500
(HP) (yield gpm)
Electric
(type power)
- (7) electric log No
(yes or no)

RECEIVED
MAR 18 1987

Department of Natural Resources
Bureau of Land & Water Resources

(organization running log)


(8) how well bottom plugged Plate

DRILLERS REMARKS:

86260 MGS-01

If well telescopes please sketch and show depths.

GROUND LEVEL

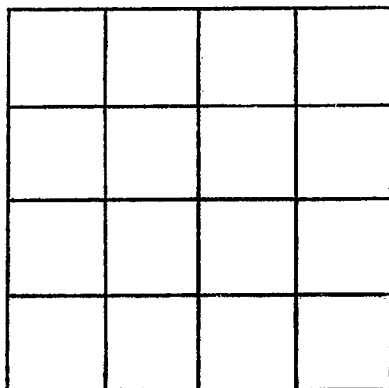

SECTION _____

Please indicate well location X.

ADDITIONAL INFORMATION

If more than one screen,
show locations of each on sketch.