

MISSISSIPPI DEPARTMENT OF NATURAL RESOURCES

Bureau of Land and Water Resources

Southport Mall

P.O. Box 10631

Jackson, Mississippi 39209

WATER WELL DRILLERS LOG

CODED

D-51-87

SUNFLOWER
 Permit L 113
 # MSGW-
07673

date well completed 7-12 1987 firm name Dyer Well, Inc county well located Sunflower

LANDOWNER:	description of formations encountered	from	to
<u>Morgan farm</u> <u>P.O. Shaw, Ms.</u> (mailing address)			
WELL LOCATION:			
sec. <u>29</u> T. <u>20</u> N. S. R. <u>3</u> E. <u>W</u>			
_____ miles (distance) _____ miles (direction) of <u>Sunflower</u> (nearest town)			
WELL PURPOSE: <u>irrigation</u> (home, irrigation, municipal, industrial)			
WELL COMPLETION DATA:			
(1) diameter (inches) <u>16"</u>			
(2) total depth (feet) <u>105</u>			
(3) static water level (feet) _____ below/above top of ground.			
(4) casing <u>Steel</u> (material), _____ (depth), <u>16</u> (size) if telescope see back.			
(5) screen <u>40'</u> (length), _____ (depth to top) <u>16"</u> (size), <u>Steel</u> (material)			
(6) pump <u>30</u> (HP), <u>1500</u> (yield gpm) <u>electric</u> (type power)			
(7) electric log <u>No</u> (yes or no)			
(8) how well bottom plugged <u>Plate</u>			
DRILLERS REMARKS: <u>Permit # MSGW-07673</u>			


RECEIVED

JUL 20 1987

Department of Natural Resources
 Bureau of Land & Water Resources

If well telescopes please sketch and show depths.

GROUND LEVEL

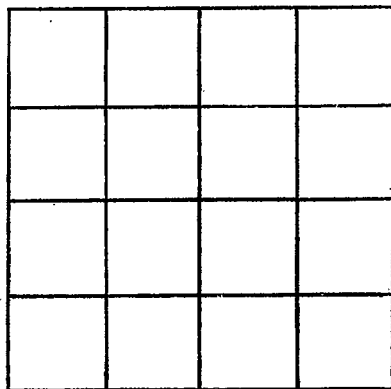

SECTION _____

Please indicate well location X.

ADDITIONAL INFORMATION

If more than one screen, show locations of each on sketch.