

MISSISSIPPI DEPARTMENT OF NATURAL RESOURCES

Bureau of Land and Water Resources

Southport Mall

P.O. Box 10631

Jackson, Mississippi 39209

WATER WELL DRILLERS LOG

Surfower
MSGW 07674
L 114

CODED

July 28 1987
 date well completed

firm name

county well located

LANDOWNER:

Morgan Bros

description of formations encountered

from

to

CLAY040Fine Sand4058M. Sand + Gravel5878Fine Sand7895Sand + Gravel95101M. Sand + Gravel101117

(mailing address)

WELL LOCATION:

sec 29 T 20 N
 S

R 3 E
 W

_____ miles
 (distance)

(direction)

_____ of Surflower
 (nearest town)

WELL PURPOSE:

Irrigation

(home, irrigation, municipal, industrial)

WELL COMPLETION DATA:

(1) diameter (inches)

16"

(2) total depth (feet)

117

(3) static water level (feet)

below
top of ground.

(4) casing

Steel

(material)

(depth)

16"

(size)

If telescope see back.

(5) screen

40'

(length)

(depth to top)

16"

(size)

(material)

(6) pump

30

(HP)

1500

(yield gpm)

Electric

(type power)

(7) electric log

No

(yes or no)

None

(organization running log)

(8) how well bottom plugged

Plate

RECEIVED


JUL 31 1987

DRILLERS REMARKS:

Department of Natural Resources
 Bureau of Land & Water Resources

If well telescopes please
sketch and show depths.

GROUND LEVEL

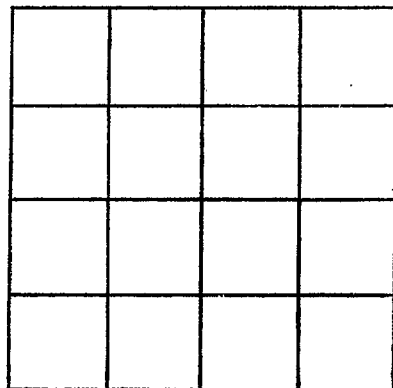

SECTION _____

Please indicate well location X.

ADDITIONAL INFORMATION

If more than one screen,
show locations of each on sketch.