

MISSISSIPPI DEPARTMENT OF NATURAL RESOURCES

Bureau of Land and Water Resources

Southport Mall

P.O. Box 10631

Jackson, Mississippi 39209

WATER WELL DRILLERS LOG

Permit Applied For

Sunflower

Log # 158363

3-24 1988  
date well completed

Dyer Well  
firm name

Sunflower  
county well located

LANDOWNER Bebe C. Romine

description of formations encountered

from

to

Rt 1 Box 115

Clay 0 30

Sunflower Ms. 38778  
(mailing address)

fine sand 30 45  
sand & gravel 45 105

WELL LOCATION:

127D sec 21 T 20 N R 3 E  
3 miles N of Sunflower  
(distance) (direction) (nearest town)

WELL PURPOSE: Irrigation  
(home, irrigation, municipal, industrial)

WELL COMPLETION DATA:

(1) diameter (inches) 10"

(2) total depth (feet) 105'

(3) static water level (feet) \_\_\_\_\_ below above top of ground.

(4) casing steel (material) (depth)

10 If telescope see back.  
(size)

(5) screen 40 (length) (depth to top)

10 (size) (material)

(6) pump 15 (HP) (yield gpm)

Elec (type power)

(7) electric log No (yes or no)

Nave (organization running log)

(8) how well bottom plugged Plate

RECEIVED


MAY 02 1988

Department of Natural Resources  
Bureau of Land & Water Resources

DRILLERS REMARKS:

If well telescopes please  
sketch and show depths.

GROUND LEVEL

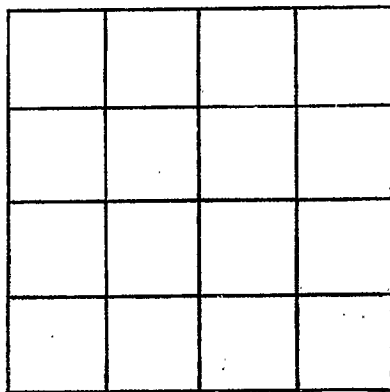

SECTION \_\_\_\_\_

Please indicate well location X.

ADDITIONAL INFORMATION

If more than one screen,  
show locations of each on sketch.