

MISSISSIPPI DEPARTMENT OF NATURAL RESOURCES

Bureau of Land and Water Resources

Southport Mall

P.O. Box 10631

Jackson, Mississippi 39209

WATER WELL DRILLERS LOG

Permit
Applied For
Construction

9369
L 116

3-29 1988
date well completed:

Dyer Well
firm name

Sunflower
county well located

LANDOWNER: Clint Owen

RT 1

Sunflower Mo.
(mailing address)

description of formations encountered

	from	to
Clay	0	34
Sand & Gravel	34	58
Fine Sand	58	74
M Sand & Gravel	74	108

WELL LOCATION:

127D sec 21 T 20 N R 3 E
3 miles W of Sunflower
(distance) (direction) (nearest town)

WELL PURPOSE: Irrigation
(home, irrigation, municipal, industrial)

WELL COMPLETION DATA:

- (1) diameter (inches) 16"
- (2) total depth (feet) 108'
- (3) static water level (feet) _____ below/above top of ground.
- (4) casing steel (material), _____ (depth)
- 16 (size) if telescope see back.
- (5) screen 40 (length), _____ (depth to top)
- 16 (size), _____ (material)
- (6) pump 60 (HP), _____ (yield gpm)
- Bear (type power)
- (7) electric log No (yes or no)
- None (organization running log)
- (8) how well bottom plugged Plate

RECEIVED


MAY 02 1988

Department of Natural Resources
Bureau of Land & Water Resources

DRILLERS REMARKS:

If well telescopes please
sketch and show depths.

GROUND LEVEL

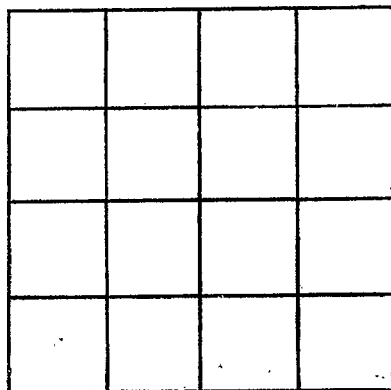

SECTION _____

Please indicate well location X.

ADDITIONAL INFORMATION

If more than one screen,
show locations of each on sketch.