

MISSISSIPPI DEPARTMENT OF NATURAL RESOURCES

Bureau of Land and Water Resources

Southport Mall

P.O. Box 10631

Jackson, Mississippi 39209

WATER WELL DRILLERS LOG

Permit Applied For 1833
SUNFLOWER L117

4-22 1988 Dyer Well Sunflower
date well completed firm name county well located


LANDOWNER: Lockett Fish
Rt 1 Box 187 Farm
Schluter, Mo. 38952
(mailing address)

description of formations encountered	from	to
<u>Cherty</u>	<u>0</u>	<u>40</u>
<u>M Sand + Gravel</u>	<u>40</u>	<u>50</u>
<u>Sand + Gravel</u>	<u>50</u>	<u>76</u>
<u>Fine Sand + Gravel</u>	<u>76</u>	<u>90</u>
<u>Sand + Gravel</u>	<u>90</u>	<u>112</u>

WELL LOCATION:
sec 22 T 20 N R 3 W
10 miles NE of Sunflower
(distance) (direction) (nearest town)

WELL PURPOSE: Irrigation (Fish)
(home, irrigation, municipal, industrial)

- WELL COMPLETION DATA:
- (1) diameter (inches) 16"
 - (2) total depth (feet) 112'
 - (3) static water level (feet) _____ below/above top of ground.
 - (4) casing steel (material), _____ (depth),
16 if telescope see back. (size)
 - (5) screen 40 (length), _____ (depth to top),
16 (size), _____ (material)
 - (6) pump 60 (HP), 3000 (yield gpm),
Gear (type power)
 - (7) electric log No (yes or no),
Nave (organization running log)
 - (8) how well bottom plugged Plate

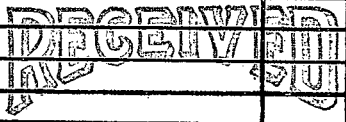


MAY 02 1988

Department of Natural Resources
Bureau of Land & Water Resources

DRILLERS REMARKS:

If well telescopes please sketch and show depths.

GROUND LEVEL

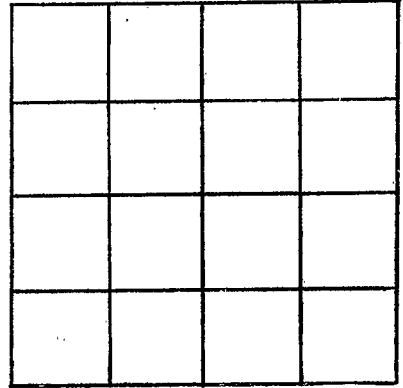

SECTION _____

Please indicate well location X.

ADDITIONAL INFORMATION

If more than one screen,
show locations of each on sketch.