

MISSISSIPPI DEPARTMENT OF NATURAL RESOURCES

Bureau of Land and Water Resources

Southport Mall

P.O. Box 10631

Jackson, Mississippi 39209

WATER WELL DRILLERS LOG

Permit
Applied For
SUNFLOWER

1832
L 118

4-28 1988
date well completed

Dyer Well
firm name

Sunflower
county well located

LANDOWNER: Locket Fish

RT 1 Box 187 Farm

Schlater, Ms. 38952
(mailing address)

WELL LOCATION:

128° sec 22 T 20 N R 3
10 miles NE of Sunflower
(distance) (direction) (nearest town)

WELL PURPOSE: Irrigation
(home, irrigation, municipal, industrial)

WELL COMPLETION DATA:

- (1) diameter (inches) 16"
- (2) total depth (feet) 107'
- (3) static water level (feet) _____ below above top of ground.
- (4) casing steel (material) _____ (depth) _____
16" if telescope see back. (size)
- (5) screen 40 (length) _____ (depth to top) _____
16 (size) _____ (material)
- (6) pump 60 (HP) 3000 (yield gpm)
Gen (type power)
- (7) electric log No (yes or no)
None (organization running log)
- (8) how well bottom plugged PLATE

description of formations encountered

from

to

<u>Clay</u>	<u>0</u>	<u>28</u>
<u>Fine Sand</u>	<u>28</u>	<u>55</u>
<u>Sand & Gravel</u>	<u>55</u>	<u>98</u>
<u>M Sand & Gravel</u>	<u>98</u>	<u>107</u>

(Fish)

RECEIVED


MAY 02 1988

Department of Natural Resources
Bureau of Land & Water Resources

DRILLERS REMARKS:

If well telescopes please sketch and show depths.

GROUND LEVEL

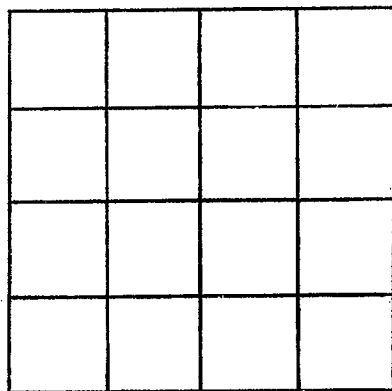

SECTION _____

Please indicate well location X.

ADDITIONAL INFORMATION

If more than one screen,
show locations of each on sketch.