

MISSISSIPPI DEPARTMENT OF ENVIRONMENTAL QUALITY
Bureau of Land and Water Resources

P. O. Box 10631
Jackson, MS 39289-0631
WATER WELL DRILLERS LOG

COUNTY WELL LOCATED	
Sunflower	
WELL NUMBER	CODED
Site-4 Well-1	
SU-L702	L135
DATE WELL COMPLETED	
6/3/94	

PERMIT NUMBER
NAME OF DRILLING FIRM
Layne-Central

NAME & MAILING ADDRESS OF LANDOWNER			
Turner Arant			
Route 1, Box B-1			
Sunflower, MS 38778			
WELL LOCATION	SEC	TOWNSHIP	RANGE
	18	T20	R3
		N S	E W
DISTANCE	DIRECTION	NEAREST TOWN	
	Miles	of	
OTHER LANDMARK			
WELL PURPOSE: Home Irrigation, Municipal, Industrial, Fish Pond, etc.			
Observation			

PUMP DATA			N/A
PUMP TYPE (Circle One): Submersible, Turbine, Jet, Flowing Well, Other (Describe)			
POWER TYPE (Circle One): Electric, Tractor, Diesel, Gasoline, Butane, Other (Describe)			
Pump Capacity (GPM)	No. of Stages	Setting Depth	FT.
PUMP TEST			
Well yielded _____ GPM with			
a drawdown of _____ ft.			
after _____ hours of pumping			

WELL DATA		
Well Depth	Casing Diameter (In.)	Casing Length (Ft.)
182'	6" x 4"	172'
Type of Casing	Hole Depth	Depth to Static Water Level
PVC	220	68'
TYPE OF COMPLETION: (Circle One or More):		
Gravel Packed, Underreamed, Telescoped, Natural Development, Open Hole, Other (Describe)		
Top of Lap Pipe or Reduction in Casing		
6 FEET		
IF TELESCOPED OR MORE THAN ONE SCREEN: USE BACK PAGE		

LOG DATA	
TYPE OF LOG RUN (Circle One):	
Electric, Gamma Ray, Density, Sonic, Neutron, Other (Describe)	
Name of Organization Running Log	
State	

SCREEN DATA		
Diameter - Inches	Length - Feet	Slot Size - Inches
4"	10'	.010"
Screen Type	Depth to Bottom - Feet	
PVC	195'	

GEOLOGIC DATA (Office Use Only)			
Surface Elev.	Geologic Unit	Unit Thickness	Depth to Top
Subs. SWL	Date	Analysis	Aquifer Test
Driller's Remarks			

DESCRIPTION OF FORMATIONS ENCOUNTERED	FROM	TO	FORMATIONS (Continued)	FROM	TO
Hard Clay	0	20	Light Sand	180	220
Clay	20	40			
Coarse Sand	40	60			
Gravel Sand	60	70			
Peat Gravel	70	80			
Sand	80	100			
Coarse Sand	100	115			
Gravel	115	120			
Clay	120	140			
Clay	140	160			
Sand Clay Stk.	160	180			


RECEIVED

JUL 25 1994

Dept. of Environmental Quality
Office of Land & Water Resources

IF MORE SPACE IS NEEDED, USE BACK

If well telescopes please sketch and show depths.

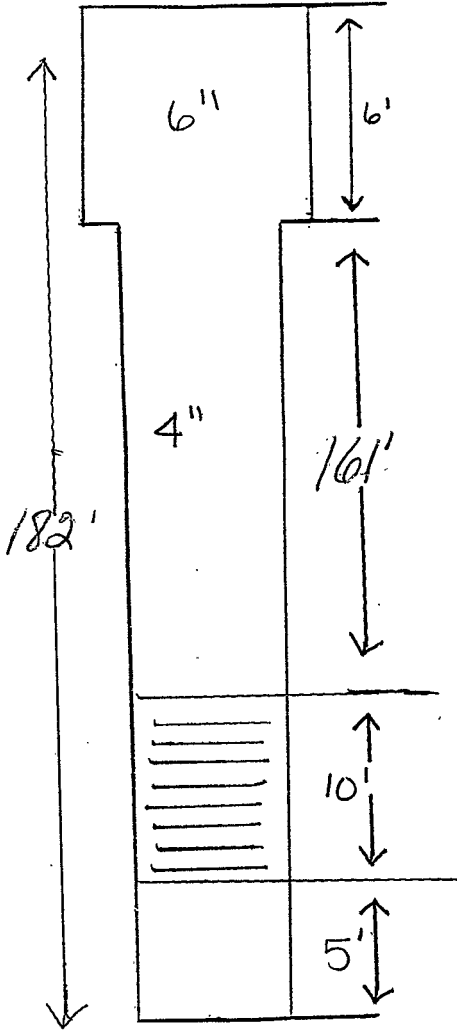

SECTION _____

Please indicate well location X.

ADDITIONAL INFORMATION

If more than one screen,
show location of each on sketch.