Permit #: <u>GW40178</u> Irrigation Equipment Driller: Date drilling completed: <u>4-28-05</u>	Jackson, MS 39289-0631		For Office Use Only:    Aquifer:    Well #:
30 days of completion of drilling Well Owner Informa	; of the well.		
Owner Name Diversified	Farms	<b>30</b> 33 38.3	Location 90 30 40.9 _" Longitude:
c/o Fischer Fa: Mailing Address:		Method of Lat/Long (circle or	
Box 926			IGPS, Survey-grade GPS
Aberdeen, MS City Sta Telephone No. (662-369-953	te Zip Code	SW NE Distance Direction	3 Twn 20N Rng 3W Nearest Town of Sunflower
	Well	Data	
If flowing, method of flow regulation: Val	lve Other (a		
Static Water Level: 53' feet al Method of Measurement (circle one)	cove of below (circle one) cel tape electric tape	land surface Date measured:	4-30-05
Static Water Level: 53' feet al Method of Measurement (circle one) s Hole depth: 127' Well dep	cove of below (circle one) cel tape electric tape	land surface Date measured: air line other: Well grouted to a depth of	4-30-05
Static Water Level: 53' feet al Method of Measurement (circle one) s Hole depth: 127' Well dep	pove of below)(circle one) cel tape electric tape pth: <u>127'</u> fentonite Mix	land surface Date measured: air line other: Well grouted to a depth of	<u>4-30-05</u> <u>10</u> <u>feet</u>
Static Water Level: <u>53'</u> feet al Method of Measurement (circle one) s Hole depth: <u>127'</u> Well dep Type of grout (circle one): Cement	bove of below)(circle one) cel tape electric tape pth: <u>127'</u> fentonite Mix ng diameter: <u>16</u>	land surface Date measured: air line other: Well grouted to a depth of inches Type of casing:	<u>4-30-05</u> <u>10</u> <u>feet</u> PVC Sch.40
Static Water Level:  53' feet al:    Method of Measurement (circle one)  static Well dep    Hole depth:  127'  Well dep    Type of grout (circle one):  Cement    Casing length:  87 feet  Casing    Screen length:  40 feet  Screen	bove of below (circle one) eel tape electric tape pth: <u>127</u> ' Mix ng diameter: <u>16</u> en diameter: <u>16</u>	land surface Date measured: air line other: Well grouted to a depth of inches Type of casing:	4-30-05 10feet PVC Sch.40 PVC Sch.40
Static Water Level:  53' feet al:    Method of Measurement (circle one)  static Well dep    Hole depth:  127'    Type of grout (circle one):  Cement    Casing length:  87 feet  Casing    Screen length:  40 feet  Screen	bove of below)(circle one) cel tape electric tape pth: <u>127'</u> fentonite Mix ng diameter: <u>16</u> setting depth: From _ ravel packed Under	land surface  Date measured:	<u>4-30-05</u> <u>10</u> <u>feet</u> <u>PVC Sch.40</u> <u>127</u> <u>feet</u> hole Natural Development
Static Water Level:  53' feet al    Method of Measurement (circle one)  static Water Level:    Hole depth:  127'    Well depth:  000000000000000000000000000000000000	bove of below)(circle one) eel tape electric tape oth: <u>127'</u> fentonite Mix ng diameter: <u>16</u> en diameter: <u>16</u> Setting depth: From _ Gravel packed Under Other (describe): feet. If te preserve of below)(circle one) Mix	land surface  Date measured:	4-30-05 10 feet PVC Sch. 40 PVC Sch. 40 127 feet hole Natural Development reen, describe on back of page Other:
Static Water Level:  53' feet all    Method of Measurement (circle one)  static Water Level:    Hole depth:  127'    Type of grout (circle one):  Cement    Casing length:  87 feet  Casin    Screen length:  40 feet  Scree    Screen slot size:  .050 inches    Type of completion (circle all applicable):    Top of lap pipe or reduction in casing:    Logs run (circle all applicable):  No log run    Name of organization running log(s):  I certify that the well was drilled, constr    Department of Environmental Quality and the state of the state	bove of below)(circle one) eel tape electric tape pth: <u>127'</u> fentonite Mix ng diameter: <u>16</u> en diameter: <u>16</u> Setting depth: From <u>16</u> Setting depth: From <u>16</u> Cravel packed Under Other (describe): <u>feet. If te</u> Electric Gamma Ray ucted, and completed in und/or the Mississippi De	land surface  Date measured:	4-30-05 10 feet PVC Sch.40 PVC Sch.40 127 feet a hole Natural Development reen, describe on back of page Other:
Static Water Level:  53' feet all    Method of Measurement (circle one)  static Water Level:    Hole depth:  127'    Type of grout (circle one):  Cement    Casing length:  87 feet  Casin    Screen length:  40 feet  Scree    Screen slot size:  050 inches    Type of completion (circle all applicable):    Top of lap pipe or reduction in casing:    Logs run (circle all applicable):    No log run    Name of organization running log(s):    I certify that the well was drilled, construction	bove of below)(circle one) teel tape electric tape oth: <u>127'</u> fentonite Mix ng diameter: <u>16</u> en diameter: <u>16</u> Setting depth: From _ Gravel packed Under Other (describe): feet. If te perfect in the Mississippi Dep tipment Inc.	land surface  Date measured:	4-30-05 10feet PVC Sch.40 PVC Sch.40 127feet a hole Natural Development reen, describe on back of page Other:


RECEIVED MAY 19 2005 BY: OLWR If well telescopes please sketch below and show depths.

Ground Level

L	-	176

Description of Formations Encountered	From	To
Clay	0	20
Clay Fine Sand	21	55
Med Sand/gravel	56	65
Med. Sand/gravel Coarse Sand/gravel	66	127
<u> </u>		
	Ι	
	T	$\top$
	1	
	1	
	+	1

If more than one screen, show location of each on sketch

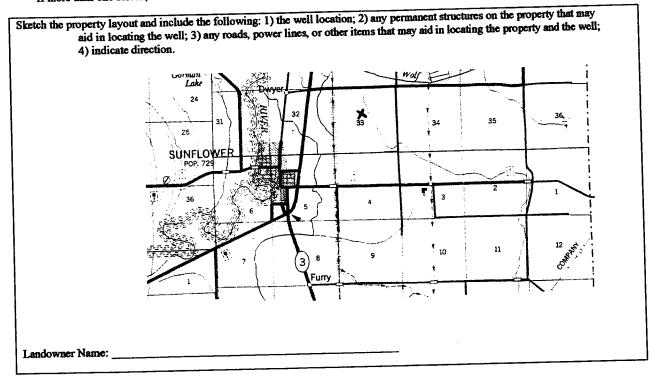

Signature of Water Well Contractor

-**∀** 

-

STATE WELL REPORT		
County:Sunflower Permit#: Irrigation Equipment Driller: Date completed:4-30-05_	Part 2 Pump Installer's Completion Report Mississippi Department of Environmental Quality Office of Land and Water Resources P.O. Box 10631 Jackson, MS 39289-0631 (601)961-5210 (601)354-6938 (fax)	For Office Use Only:      Aquifer:

\* .

This report should be prepared by the pump installer in detail and filed with the Department within 30 days of the installation of pump.

Well Owner Information	Well Location	
Owner Name: Diversified Farms c/o Fischer Farm Services Mailing Address:	Latitude: Longitude: Method of Lat/Long (circle one): Conventional Survey,	
Box 926	USGS quad, Hand-held GPS, Survey-grade GPS	
Aberdeen, MS 39730	<u>SE4 NW 4 Sec 33 Twn 20N Rng 3W</u>	
City State Zip Code	Distance Direction Nearest Town	
662-369-9531 Telephone No. ()		

	Pump Ty Circle of			Power Type Circle one	de an faille an ann an an an dùthach an air an
Air Lift	Jet	Submersible	Diesel Engine	Gasoline Engine	Natural Gas
Bucket	Piston	Turbine	Electric Motor	Hand	Tractor PTO
Centrifugal	Rotary	Flowing Well	Windmill	Other (specify):	
Other (specify):			Horse Power Ratin	ng of Motor: <u>60</u>	
Date Pump Installed:	4-3	0-05	Setting Depth:	70	feet
Rated Pump Capacity:	2500	- 3000 Gallons Per Minute	Number of Stages:	1	

Pump Test Data	Method of Measuring Water Level Circle one		
Date Well Tested:	Air Line Electric Measuring Line Steel Tape		
Static Water Level (A):Feet Below Land Surface	Other (specify):		
Pumping Water Level (B):Feet Below Land Surface	Outer (specify).		
Drawdown [(B) – (A)]:Feet Below Land Surface	For flowing well, measured shut in head:feet		
Test Pumping Rate:Gallons Per Minute	Well yielded GPM with a drawdown of		
Duration of Pump Test (minimum 4 hours):hours	feet afterhours of pumping		

I HEREBY CERTIFY that the above statements are true to the best	of my jenowiedge.
Patrick M. Chism 0695	Hatil M Chim Signature of Pump Installer
Print Name of Pump Installer and License No. (if applicable)	Signature of Pump Installer

RECEIVED MAY 1 9 2005 BY: OLWR