

Sunflower  
L2000  
6-24-76

MISSISSIPPI  
 BOARD OF WATER COMMISSIONERS  
 416 North State Street  
 Jackson, Mississippi 39201

WATER WELL DRILLERS LOG

6-24  
 date well completed

1976 Delta Well & Supply  
 firm name

Sunflower  
 county well located

LANDOWNER: Dr. Ross +  
Breuer Margon  
Sunflower Mines  
 (mailing address)  
 WELL LOCATION:  
 sec. 33 T 20 N R 3 W  
2 miles NE of Sunflower  
 (distance) (direction) (nearest town)

description of formations encountered	from	to
Top soil	0	14
sand	14	90
gravel & sand	90	122
Clay	122	300
Coquina sand	300	380
Clay	380	415
fine sand	415	485
Clay	485	630
Rock at	600	
good sand	630	680
Clay	680	702
lit at	672	

WELL PURPOSE: Home  
 (home, irrigation, municipal, industrial)

WELL COMPLETION DATA:  
 (1) diameter (inches) 4" x 2"  
 (2) total depth (feet) 672  
 (3) static water level (feet) 17 below above top of ground.  
 (4) casing 4" x 2" (material) (depth)  
 (size) if telescope see back.  
 (5) screen 20' (length) (depth to top)  
2" (size) Stainless Steel (material)  
 (6) pump 1 (HP) 20 (yield gpm)  
Elec. (type power)  
 (7) electric log No (yes or no)  
 (organization running log)  
 (8) how well bottom plugged B.P. Volval

RECEIVED  
 JUL 19 1976

DRILLERS REMARKS:

MISS. BD OF WATER COMM


If well telescopes please sketch and show depths.

GROUND LEVEL

4"  
105 ft

2"

2"  
~~20'~~  
Stainless steel  
20'

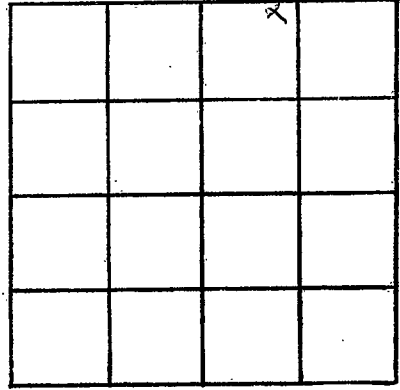

SECTION 33

Please indicate well location X.

ADDITIONAL INFORMATION

If more than one screen, show locations of each on sketch.