

MISSISSIPPI DEPARTMENT OF NATURAL RESOURCES

Bureau of Land and Water Resources

COUNTY WELL LOCATED  
*Sunflower*  
 WELL NUMBER  
*L*  
 CODED  
 DATE WELL COMPLETED  
*2005*  
*7-9-90*

PERMIT NUMBER  
*TEP MS-GW-12861*  
 NAME OF DRILLING FIRM  
*Dyer Well*

P.O. Box 10631  
 Jackson, Mississippi 39209  
 WATER WELL DRILLERS LOG

NAME & MAILING ADDRESS OF LANDOWNER  
*Tacket Fish Farm*  
*Rt 1 Box 187*  
*Schlater, Ms. 38952*  
 WELL LOCATION: SEC *14* TOWNSHIP *20* RANGE *3*  
 DISTANCE \_\_\_\_\_ MILES \_\_\_\_\_ OF \_\_\_\_\_  
 DIRECTION \_\_\_\_\_ NEAREST TOWN \_\_\_\_\_  
 OTHER LANDMARK \_\_\_\_\_  
 WELL PURPOSE: Home, Irrigation, Municipal, Industrial, Fish Pond, etc.

PUMP DATA  
 PUMP TYPE (Circle One):  
 Submersible, Turbine, Jet, Flowing Well,  
 Other (Describe) \_\_\_\_\_  
 POWER TYPE (Circle One):  
 Electric, Tractor, Diesel, Gasoline, Butane,  
 Other (Describe) \_\_\_\_\_ H/P \_\_\_\_\_  
 Pump Capacity (GPM) *3000* No. of Stages *1* Setting Depth *60* FT.  
 PUMP TEST  
 Well yielded \_\_\_\_\_ GPM with  
 a drawdown of \_\_\_\_\_ ft.  
 after \_\_\_\_\_ hours of pumping

WELL DATA  
 Well Depth *110'* Casing Diameter (In.) *16"* Casing Length (Ft.) *70'*  
 Type of Casing *steel* Hole Depth \_\_\_\_\_ Depth to Static Water Level \_\_\_\_\_  
 TYPE OF COMPLETION: (Circle One or More):  
Gravel Packed, Underreamed, Telescoped,  
 Natural Development, Open Hole, Other \_\_\_\_\_  
 (Describe) \_\_\_\_\_  
 Top of Lap Pipe or Reduction in Casing \_\_\_\_\_  
 FEET IF TELESCOPED OR MORE THAN ONE SCREEN: USE BACK PAGE


LOG DATA  
 TYPE OF LOG RUN (Circle One): No Log Run  
 Electric, Gamma Ray, Density, Sonic, Neutron,  
 Other (Describe) \_\_\_\_\_  
 Name of Organization Running Log  
*None*

SCREEN DATA  
 Diameter - Inches *16"* Length - Feet *40'* Slot Size - Inches *.030*  
 Screen Type *White Wrap* Depth to Bottom - Feet \_\_\_\_\_

GEOLOGIC DATA (Office Use Only)

Surface Elev.	Geologic Unit	Unit Thickness	Depth to Top
Subs. SWL	Date	Analysis	Aquifer Test


Driller's Remarks

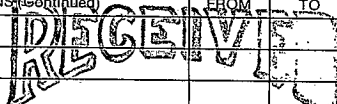DESCRIPTION OF FORMATIONS ENCOUNTERED	FROM	TO	FORMATIONS (Continued)	FROM	TO
<i>Clay</i>	<i>0</i>	<i>28</i>	 <b>RECEIVED</b> <b>DEC 14 1990</b> Department of Natural Resources Bureau of Land & Water Resources		
<i>Fine Sand</i>	<i>28</i>	<i>40</i>			
<i>Fine Sand &amp; Gravel</i>	<i>40</i>	<i>54</i>			
<i>M Sand &amp; Gravel</i>	<i>54</i>	<i>90</i>			
<i>Fine Sand &amp; Gravel</i>	<i>90</i>	<i>98</i>			
<i>Sand &amp; Gravel</i>	<i>98</i>	<i>108</i>			
<i>Fine Sand &amp; Gravel</i>	<i>108</i>	<i>110</i>			

IF MORE SPACE IS NEEDED, USE BACK.

If well telescopes please  
sketch and show depths.

GROUND LEVEL

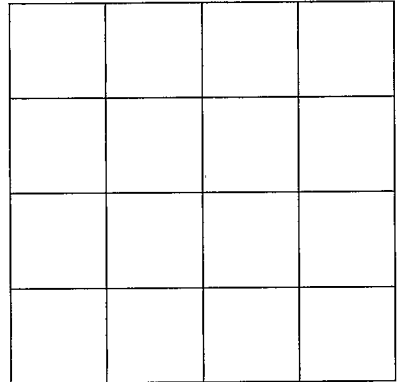

SECTION \_\_\_\_\_

Please indicate well location X.

ADDITIONAL INFORMATION

If more than one screen,  
show location of each on sketch.