

MISSISSIPPI DEPARTMENT OF ENVIRONMENTAL QUALITY

Office of Land and Water Resources

COUNTY WELL LOCATED Sunflower	
WELL NUMBER L	CODED
DATE WELL COMPLETED 2018 8-16-95	

PERMIT NUMBER
NAME OF DRILLING FIRM Irrigation Equipment
Indianola, MS 38751

P. O. Box 10631
Jackson, MS 39289-0631
WATER WELL DRILLERS LOG

NAME & MAILING ADDRESS OF LANDOWNER J.R. & K Fish Farm		
81 Bush Holeman Road Sunflower, MS 38778		
James Ray Holeman		
WELL LOCATION:	SEC	TOWNSHIP
	5	20N N 3W E S W
DISTANCE	DIRECTION	NEAREST TOWN
1 Miles	North	of Blaine
OTHER LANDMARK		
WELL PURPOSE: Home, Irrigation, Municipal, Industrial, Fish Pond, etc. Fish Pond		

PUMP DATA		
PUMP TYPE (Circle One): <u>Submersible</u> , Turbine, Jet, Flowing Well, Other (Describe) _____		
POWER TYPE (Circle One): <u>Electric</u> , Tractor, Diesel, Gasoline, Butane, Other (Describe) _____ H/P 25		
Pump Capacity (GPM)	No. of Stages	Setting Depth
1100	1	80 FT.
PUMP TEST		
Well yielded _____ GPM with a drawdown of _____ ft. after _____ hours of pumping		

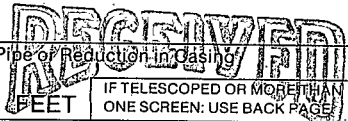
WELL DATA		
Well Depth	Casing Diameter (In.)	Casing Length (Ft.)
115	10	75
Type of Casing	Hole Depth	Depth to Static Water Level
PVC	115	50 ft.

LOG DATA	
TYPE OF LOG RUN (Circle One): <u>Electric</u> , Gamma Ray, Density, Sonic, Neutron, Other (Describe) _____	
Name of Organization Running Log	

TYPE OF COMPLETION: (Circle One or More): <u>Gravel Packed</u> , Underreamed, Telescoped, Natural Development, Open Hole, Other (Describe) _____		
WELL GROUTED TO A DEPTH OF _____ FEET Type Grout (circle one): Cement, Bentonite, or Mix		

GEOLOGIC DATA (Office Use Only)			
Surface Elev.	Geologic Unit	Unit Thickness	Depth to Top
Subs. SWL	Date	Analysis	Aquifer Test

SCREEN DATA		
Diameter - Inches	Length - Feet	Slot Size - Inches
10	40	.032
Screen Type	Depth to Bottom - Feet	
PVC	115	

Driller's Remarks

Top of Lap Pipe or Reduction in Casing FEET
IF TELESCOPED OR MORE THAN ONE SCREEN: USE BACK PAGE

DESCRIPTION OF FORMATIONS ENCOUNTERED	FROM	TO
Clay	0	24
Fine Sand	24	45
Fine Sand & Gravel	45	55
Med. Sand & Gravel	55	115

FORMATIONS (Continued)	
SEP 18 1995	
FROM	TO
IF MORE SPACE IS NEEDED, USE BACK	

Dept. of Environmental Quality
Office of Land & Water Resources

If well telescopes please sketch and show depths.

GROUND LEVEL

			X

5

SECTION _____

Please indicate well location X.

ADDITIONAL INFORMATION

If more than one screen,
show location of each on sketch.