

7/22/67
 E. BODEN 17

Sunflower
 M8
 6-6-67

MISSISSIPPI
 BOARD OF WATER COMMISSIONERS
 416 North State Street
 Jackson, Mississippi 39201

WATER WELL DRILLERS LOG

June 6, 1967 Layne-Central Company Sunflower
 date well completed firm name county well located

LANDOWNER: Phillip Fratesi

description of formations encountered	from	to
Clay	0	35
Coarse sand	35	56
Coarse sand, pea gravel	56	79
Coarse sand, gravel	79	98
Fine sand	98	102

Indianola, Mississippi
 (mailing address)


WELL LOCATION:
 sec 24 T 19 N R 5 E
 3 miles north of Indianola
 (distance) (direction) (nearest town)

WELL PURPOSE: irrigation
 (home, irrigation, municipal, industrial)

WELL COMPLETION DATA:

- (1) diameter (inches) 12
- (2) total depth (feet) 101
- (3) static water level (feet) 18' 7" ~~58' 5" X~~ above top of ground.
- (4) casing steel, 71' (material), (depth), 12" (size) if telescope see back.
- (5) screen 30' (length), 101' (depth to top), 12" (size), Armco (material)
- (6) pump 20 (HP), 1200 (yield gpm), engine (type power)
- (7) electric log no (yes or no), (organization running log)
- (8) how well bottom plugged plate.

DRILLERS REMARKS:

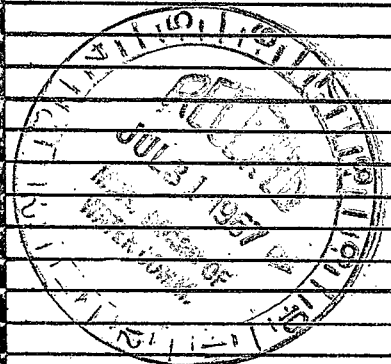

If well telescopes please sketch and show depths.

GROUND LEVEL

SECTION ~~2029~~ 24

Please indicate well location X.

ADDITIONAL INFORMATION

If more than one screen, show locations of each on sketch.