

Sunflower
M9
6-10-67

MISSISSIPPI
BOARD OF WATER COMMISSIONERS
416 North State Street
Jackson, Mississippi 39201
WATER WELL DRILLERS LOG

7/27/67
Jm
CODE 197

June 10, 1967 Layne-Central Company Sunflower
date well completed firm name county well located

LANDOWNER: Phillip Fratesi

description of formations encountered

from to

Clay	0	33
Coarse sand	33	54
Coarse sand, pea gravel	54	77
Coarse sand, gravel	77	100
Fine sand		100

Indianola, Mississippi
(mailing address)

WELL LOCATION:

sec 24 T. 19 N. R. 5 E. W. 3


_____ miles of Indianola
(distance) (direction) (nearest town)

WELL PURPOSE: irrigation
(home, irrigation, municipal, industrial)

WELL COMPLETION DATA:

- (1) diameter (inches) 12
- (2) total depth (feet) 100
- (3) static water level (feet) 18' 2" ^{meter} above top of ground.
- (4) casing steel, 70' (material), (depth),
12" (size) if telescope see back.
- (5) screen 30' 100' (length), (depth to top)
12" (size), Armco (material)
- (6) pump 20 1200 (HP), (yield gpm)
engine (type power)
- (7) electric log no (yes or no)
(organization running log)
- (8) how well bottom plugged plate

DRILLERS REMARKS:

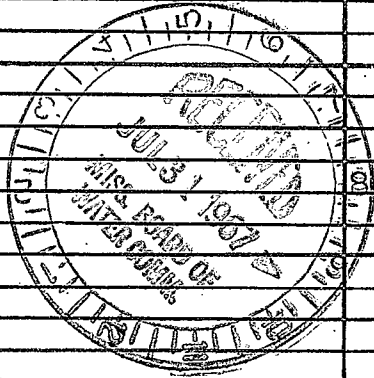

If well telescopes please sketch and show depths.

GROUND LEVEL

SECTION 24

Please indicate well location X.

ADDITIONAL INFORMATION

If more than one screen, show locations of each on sketch.