

Sunflower
M 10
6-16-67

MISSISSIPPI
 BOARD OF WATER COMMISSIONERS
 416 North State Street
 Jackson, Mississippi 39201

7/21/67
Jm
 CORDED 2397

WATER WELL DRILLERS LOG

June 16, 1967 Layne-Central Company Sunflower
 date well completed firm name county well located

LANDOWNER: Phillip Fratesi

description of formations encountered

from to

Indianola, Mississippi
 (mailing address)

Clay	0	20
Coarse sand	20	51
Coarse sand, pea gravel	51	70
Coarse sand, pea gravel and gravel	70	98
Fine sand, clay balls		98

WELL LOCATION:

sec 24 T 19 N R 5 E
 S W
 miles of Indianola
 (distance) (direction) (nearest town)

WELL PURPOSE: irrigation
 (home, irrigation, municipal, industrial)

WELL COMPLETION DATA:


- (1) diameter (inches) 12
- (2) total depth (feet) 98
- (3) static water level (feet) 18' 11" above top of ground.
- (4) casing steel, 58'
 (material), (depth)
12" if telescope see back.
 (size)
- (5) screen 40', 98'
 (length), (depth to top)
12", Armco
 (size), (material)
- (6) pump 30, 1500
 (HP), (yield gpm)
engine
 (type power)
- (7) electric log no
 (yes or no)
 (organization running log)
- (8) how well bottom plugged plate

DRILLERS REMARKS:



If well telescopes please sketch and show depths.

GROUND LEVEL

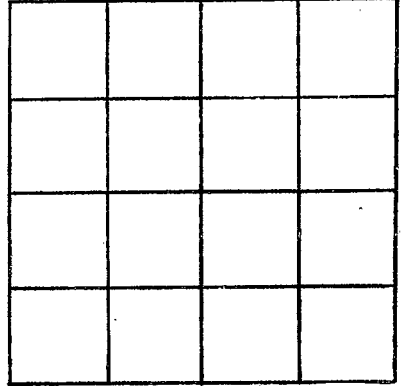

SECTION 24

Please indicate well location X.

ADDITIONAL INFORMATION

If more than one screen,
show locations of each on sketch.