

Sunflower
M 11
4-7-70

MISSISSIPPI
BOARD OF WATER COMMISSIONERS
416 North State Street
Jackson, Mississippi 39201

CODED

WATER WELL DRILLERS LOG

4-7-70 19 70 DYER WELL & IRRIGATION SERVICE Sunflower
date well completed firm name county well located

LANDOWNER:
James Robertson
Holly Ridge, Miss.
(mailing address)

description of formations encountered	from	to
CLAY	0	23
FINE SAND	23	43
COARSE SAND + GRAVEL	43	103

WELL LOCATION:
sec. 30 T-19 N R-5
1 1/2 miles N of Holly Ridge
(distance) (direction) (nearest town)

WELL PURPOSE: FRR.
(home, irrigation, municipal, industrial)

WELL COMPLETION DATA:

(1) diameter (inches) 12"

(2) total depth (feet) 103

(3) static water level (feet) 18 below top of ground.

(4) casing Steel 63 (material) (depth)
12" (size) if telescope see back.

(5) screen 40' 63 (length) (depth to top)
12" (size) Steel (material)

(6) pump 60 2000 (HP) (yield gpm)
Diesel (type power)

(7) electric log NO (yes or no)

(organization running log)

(8) how well bottom plugged Plate

CODED


APR 17 1970

DRILLERS REMARKS:

MISS. BD. OF
WATER COMM.

If well telescopes please sketch and show depths.

GROUND LEVEL

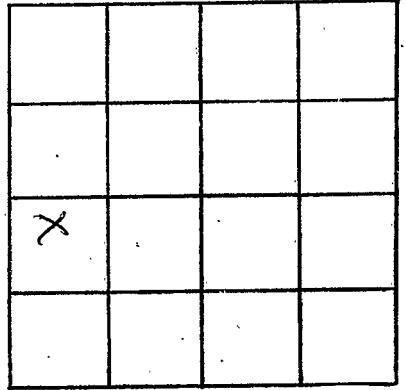

SECTION 30

Please indicate well location X.

ADDITIONAL INFORMATION

If more than one screen,
show locations of each on sketch.