

Sunflower
M 12

MISSISSIPPI
BOARD OF WATER COMMISSIONERS
416 North State Street
Jackson, Mississippi 39201

CODED

10-22-64

Billy & James Robertson
WATER WELL DRILLERS LOG

10-22-64

SUNFLOWER

date well completed

Billy & James Robertson firm name

county well located

LANDOWNER:

Holly Hill

description of formations encountered

from

to

Planting Co

(mailing address)

WELL LOCATION:

sec *32* T *19* N R *5*
4 miles *W* of *Jackson*
(distance) (direction) (nearest town)

WELL PURPOSE:

Dom & Res.
(home, irrigation, municipal, industrial)

WELL COMPLETION DATA:

- (1) diameter (inches) *10x4*
- (2) total depth (feet) *1050*
- (3) static water level (feet) *20* below top of ground.
- (4) casing *EPH* (material) *1020* (depth)
- 10x4* (size) if telescope see back.
- (5) screen *30'* (length) *1020* (depth to top)
- 4* (size) *SS* (material)
- (6) pump *5* (HP) *0* (yield gpm)
- 0* elec. subm. (type power)
- (7) electric log *no* (yes or no)
- 0* (organization running log)
- (8) how well bottom plugged *0*

<i>Clay</i>	<i>0</i>	<i>15</i>
<i>Sand</i>	<i>15</i>	<i>80</i>
<i>Gravel</i>	<i>80</i>	<i>120</i>
<i>Mud</i>	<i>120</i>	<i>328</i>
<i>Sand</i>	<i>328</i>	<i>430</i>
<i>Mud & Sand</i>	<i>430</i>	<i>511</i>
<i>Sand</i>	<i>511</i>	<i>566</i>
<i>Mud</i>	<i>566</i>	<i>588</i>
<i>Sand</i>	<i>588</i>	<i>620</i>
<i>Mud</i>	<i>620</i>	<i>640</i>
<i>Sand & Coal</i>	<i>640</i>	<i>651</i>
<i>Seal</i>	<i>651</i>	<i>709</i>
<i>Mud</i>	<i>709</i>	<i>813</i>
<i>Rock</i>	<i>813</i>	<i>814</i>
<i>Sand & mud</i>	<i>814</i>	<i>871</i>
<i>Sand</i>	<i>871</i>	<i>940</i>
<i>Mud & black sand</i>	<i>940</i>	<i>980</i>
<i>Sand</i>	<i>980</i>	<i>1050</i>
<i>Sand & Coal</i>	<i>1050</i>	<i>1052</i>

Insufficient information to code.


MISS. DIV. OF WATER CONTROL
JES

6/27/69
Repair Furnace started - just new parts
(over)

DRILLERS REMARKS:

If well telescopes please sketch and show depths.

GROUND LEVEL

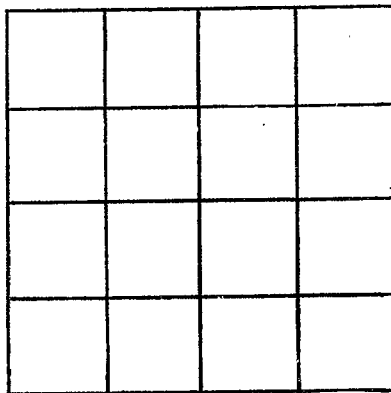

SECTION 32

Please indicate well location X.

ADDITIONAL INFORMATION

168
452
1050

1050 ft well and system as follows
168' 6" black pipe
852' 4" " "
30' 4" SS screen - asbestos .010 slot
Comb. Wash valve
5HP 3 Phase Red @ 123 submersible 4"
1000 gal Pressure tank with air release
105' 3" black drop pipe

Draw down about 3" per gal per minute

Static level 20' below surface

If more than one screen,
show locations of each on sketch.