

SUNF. WATER WELL DRILLERS LOG

CODED

Summons
County Humphreys

Date: Dec 11, 1960, Driller: Robert Z. Myrland (Name)
12-11-60

(1) Owner of Land: M.A. Tanksley
(Name)
Indiana Miss.
(Address)

(2) Location: 4 1/4, 1 1/4, Sec. 26 T19 R5,
4 miles North of Indiana
(distance) (direction) (Nearest Town)

(3) Topography: Level
(Hilly) (Flat) (Level)

(4) Purpose of Well: Domestic
(Domestic Irrigation
Municipal, Industrial, Other)

Description & Color of Materials Sand, Clay, Red Clay, Shell, etc.	Thick- ness Feet	Depth Feet
<u>SAND + Gravel</u>	<u>0</u> <u>to</u>	<u>200</u>
<u>Sand + Gumbo</u>	<u>20</u>	<u>117</u>
<u>Sand + Gumbo Strakes</u>	<u>70</u>	<u>483</u>
<u>mostly shale + sand shale</u>	<u>800</u>	
<u>Sand</u>	<u>70</u>	<u>60'</u>
	<u>860</u>	

Information upon completion of well:


- (1) Diameter 2" inches.
- (2) Total Depth 859'10" feet.
- (3) Water Level 15'6" feet below top of ground.
- (4) Cased to 859'10", Size 12"
- (5) Screen: Size 2", Length 20'
- (6) Were any formations sealed against pollution?
✓ yes, no.

If YES depth of formation _____

Why all formations were sealed off except the well sand

Drillers Remarks: _____

CODED

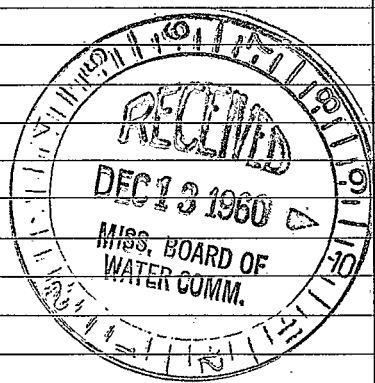

(Use Back Side)

Well No. _____

