

SUNFLOWER
M17
6-25-74

MISSISSIPPI
BOARD OF WATER COMMISSIONERS
416 North State Street
Jackson, Mississippi 39201

CODED

WATER WELL DRILLERS LOG

June 25, 74
date well completed

19 OVER WELL & IRRIGATION SERVICE
firm name

SUNFLOWER
county well located

LANDOWNER:	description of formations encountered	from	to
BURNS PET INC	CLAY	0	20
INDIANOLA, MISS (mailing address)	COARSE SAND & FEA IRON	20	57
WELL LOCATION: sec 35 T 19 N R 5 E 2 1/2 miles W of INDIANOLA (distance) (direction) (nearest town)	COARSE SAND FEA RICK & GRAVEL	57	119
WELL PURPOSE: ICE FISH (home, irrigation, municipal, industrial)			
WELL COMPLETION DATA:			
(1) diameter (inches) 12"			
(2) total depth (feet) 119'			
(3) static water level (feet) 19' below top of ground.			
(4) casing B.T.M. 79' (material) (depth)			
12" if telescope see back. (size)			
(5) screen 40 79' (length) (depth to top)			
12" BEX IN BOT (size) (material)			
(6) pump 60 2000 (HP) (yield gpm)			
BUTANE (type power)			
(7) electric log 1/2 (yes or no)			
(organization running log)			
(8) how well bottom plugged PLATE			
DRILLERS REMARKS:			

CODED


RECEIVED

NOV 21 1974

MISS. BD. OF WATER COMM

If well telescopes please
sketch and show depths.

GROUND LEVEL

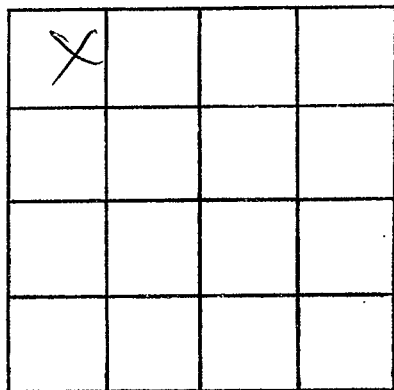

SECTION 35

Please indicate well location X.

ADDITIONAL INFORMATION

If more than one screen,
show locations of each on sketch.