

Sunflower  
M 20  
6-67

MISSISSIPPI  
 BOARD OF WATER COMMISSIONERS  
 416 North State Street  
 Jackson, Mississippi 39201  
 WATER WELL DRILLERS LOG

June 16 1967 Dyer Well & Irr. Ser. Sunflower  
 date well completed firm name county well located

LANDOWNER: Billups Plt. Inc.

R. R. Indianola,

Miss.

(mailing address)

WELL LOCATION:

sec 35 T. 19 N. R. 5 E. W  
 & W  
3 miles west of Indianola  
 (distance) (direction) (nearest town)

WELL PURPOSE: Irrigation  
 (home, irrigation, municipal, industrial)

WELL COMPLETION DATA:

- (1) diameter (inches) 10"  
 (2) total depth (feet) 113'  
 (3) static water level (feet) 18' below above  
 top of ground.  
 (4) casing Blk. Ir., 81'  
 (material) (depth)

         if telescope see back.  
 (size)

- (5) screen 32', 81'  
 (length) (depth to top)

10", Blk. Ir.  
 (size) (material)

- (6) pump 28 1500  
 (HP) (yield gpm)

Butane Power Unit  
 (type power)

- (7) electric log           
 (yes or no)

          
 (organization running log)


- (8) how well bottom plugged Steel  
 plate welded on bottom

DRILLERS REMARKS:

description of formations  
 encountered


from to

Clay	0	13
Fine Sand	13	23
Fine sand & blue mud	23	43
Blue Clay	43	53
Fine sand	53	73
Fine sand & blue mud	73	83
Coarse sand & small gra	83	113

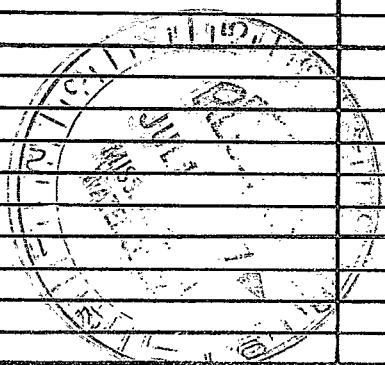

If well telescopes please sketch and show depths.

GROUND LEVEL

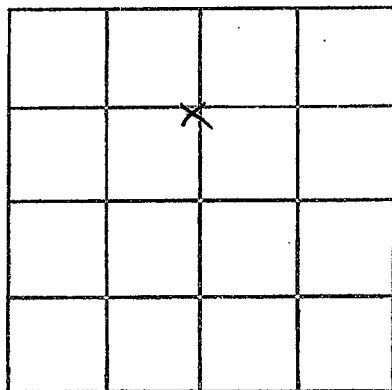

SECTION 35

Please indicate well location X.

ADDITIONAL INFORMATION

If more than one screen,  
show locations of each on sketch.