

SUNFLOWER
 M 22
 4-68

MISSISSIPPI
 BOARD OF WATER COMMISSIONERS
 416 North State Street
 Jackson, Mississippi 39201

WATER WELL DRILLERS LOG

4/1 1968 Bailey Drilling Co Sunflower
 date/well completed firm name county well located

LANDOWNER: F. J. Hall
Greenville
Miss.
 (mailing address)


WELL LOCATION:
 sec 33 T. 19 N R. 5 E
4 miles W of Indianola
 (distance) (direction) (nearest town)

WELL PURPOSE: Home
 (home, irrigation, municipal, industrial)

WELL COMPLETION DATA:

- (1) diameter (inches) 4 X 2 1/2 X 2
- (2) total depth (feet) 940
- (3) static water level (feet) 24 below above top of ground.
- (4) casing Steel
 (material) (depth)
4 X 2 1/2 X 2 if telescope see back.
 (size)
- (5) screen 15 , 925
 (length) (depth to top)
2 , Stainless Steel
 (size) (material)
- (6) pump 1 20
 (HP) (yield gpm)
elec
 (type power)
- (7) electric log NO
 (yes or no)
 (organization running log)
- (8) how well bottom plugged
Back pressure valve

description of formations encountered	depth	
	from	to
Clay	0	20
Sand	20	80
Shovel	80	100
Mud	100	300
Sand	300	400
Mud	400	650
Sand	650	700
Mud	700	895
Sand	895	940

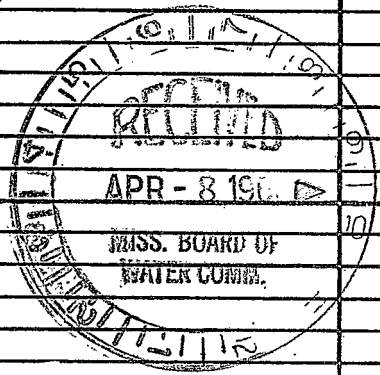

DRILLERS REMARKS:

If well telescopes please sketch and show depths.

GROUND LEVEL

126 ft 11"

110 ft 2 1/2"

587 ft 2"

15 ft strainer

		X	

SECTION 72

Please indicate well location X.

ADDITIONAL INFORMATION

If more than one screen, show locations of each on sketch.