

MISSISSIPPI
 BOARD OF WATER COMMISSIONERS
 416 North State Street
 Jackson, Mississippi 39201

WATER WELL DRILLERS LOG Billups #1

Sunflower
M 24
6-67

June 9 1967 Dyer Well & Irr. Ser. Sunflower
 date well completed firm name county well located

LANDOWNER: Billups Plt. Inc.
 R. R. 2 Indianola,
 Miss.
 (mailing address)

description of formations encountered	from	to
Clay	0	23
Fine Sand	23	43
Coarse sand	43	63
Coarse sand & small Gra.	63	103

WELL LOCATION:
 sec. 20 T. 19 N. R. 5 W.
 3 miles West of Indianola
 (distance) (direction) (nearest town)

WELL PURPOSE: Irrigation
 (home, irrigation, municipal, industrial)

- WELL COMPLETION DATA:**
- (1) diameter (inches) 16"
 - (2) total depth (feet) 103'
 - (3) static water level (feet) 17' below top of ground.
 - (4) casing Blk. Ir., 63'
 (material) (depth)
 _____ if telescope see back.
 (size)
 - (5) screen 40', 63'
 (length) (depth to top)
16", Blk. Ir.
 (size) (material)
 - (6) pump 50 2,000
 (HP) (yield gpm)
Butane Power Unit
 (type power)
 - (7) electric log No
 (yes or no)


 (organization running log)
 - (8) how well bottom plugged Steel Plate welded on bottom

DRILLERS REMARKS: _____



If well telescopes please sketch and show depths.

GROUND LEVEL

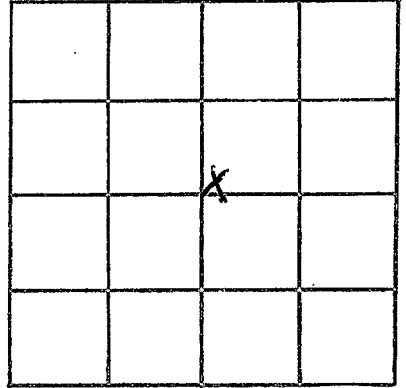

SECTION 70

Please indicate well location X.

ADDITIONAL INFORMATION

If more than one screen, show locations of each on sketch.