

Sunflower

M 25

9-66

MISSISSIPPI BOARD OF WATER COMMISSIONERS

WATER WELL DRILLERS LOG

10/11/66

22293

Date: Sept. 29, 1966, Driller: Layne-Central Company County Sunflower

(When well drilled)

(Name)

(Where well is located)

1) Owner of Land: C. J. Bishop (Name)

Indianola, Mississippi (Address)

2) Location: 1/4, 1/4, Sec. 12 T. 19N R. 5W

4 miles northwest, of Indianola (distance) (direction) (Nearest Town)

3) Topography: flat (Hilly) (Flat) (Level)

4) Purpose of Well: irrigation (Domestic Irrigation) (Municipal, Industrial, Other)

Table with 3 columns: Description & Color of Materials (Sand, Clay, Red Clay, Shell, etc.), Thickness Feet, and Depth Feet. Rows include Clay (16/16), Fine sand (8/24), Coarse sand (36/60), and Coarse sand with gravel (42/102).

Information upon completion of well:

1) Diameter 12 inches.

2) Total Depth 102 feet.

3) Water Level 16' 8" feet below top of ground.

4) Cased to 72', Size 12"

5) Screen: Size 12", Length 30'

6) Were any formations sealed against pollution? yes, no no.

YES depth of formation


Why

Drillers Remarks:

Yield in gpm:

Size pump:

Type power:

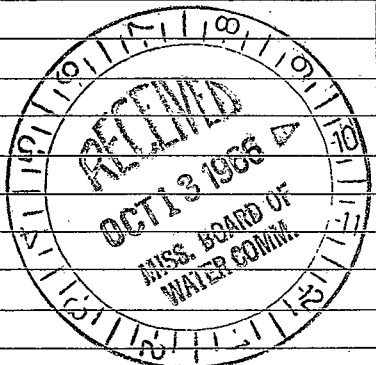

Mail this copy to Board of Water Commissioners 429 Miss. St. Jackson, Miss.

