

Sunflower
M 26
5-67

MISSISSIPPI
BOARD OF WATER COMMISSIONERS
416 North State Street
Jackson, Mississippi 39201

WATER WELL DRILLERS LOG

MAY 26, '67 date well completed Butane Gas of Greenwood firm name Sunflower county well located

LANDOWNER: AIRPORT HANGER

description of formations encountered

from to

Lewis Greer Co.

Clay

1 12

Indianola, Miss (mailing address)

Red Sand

12 32

Coarse Sand & Gravel

32 104

WELL LOCATION: NW SW

sec. 24 T. 19 N R. 5 E W

1 miles NW of Indianola (distance) (direction) (nearest town)

WELL PURPOSE: (home, irrigation, municipal, industrial)

WELL COMPLETION DATA:

(1) diameter (inches) 2"

(2) total depth (feet) 104'

(3) static water level (feet) 16 below top of ground.

(4) Galv. Steel casing (material) 84' (depth)

2" (size) if telescope see back.

(5) screen 20' (length) 84' (depth to top)

2" (size) PLASTIC (material)

(6) pump 1/2 (HP) 5 (yield gpm)


Electric (type power)

(7) electric log No (yes or no)

(organization running log)

(8) how well bottom plugged Back Pressure Valve

DRILLERS REMARKS:

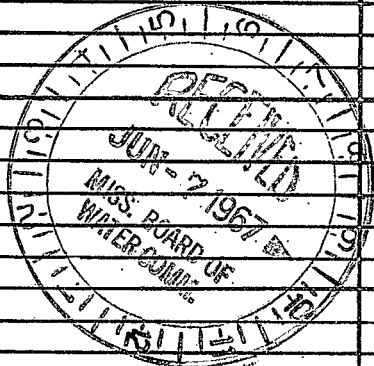

If well telescopes please sketch and show depths.

GROUND LEVEL

X			

SECTION 24

Please indicate well location X.

ADDITIONAL INFORMATION

If more than one screen,
show locations of each on sketch.