

M 27

4565-1003

11-12-62 WATER WELL DRILLERS LOG

Date: NOV. 12, 1962, Driller: DELTA DRILLING Co. County SUNFLOWER

(Name)

(1) Owner of Land: B. H. CAMPBELL
 (Name)
INDIANOLA, MISS.
 (Address)

(2) Location: NW 1/4, NE 1/4, Sec. 32 T19N R5W
 _____ miles _____ of _____
 (distance) (direction) (Nearest Town)

(3) Topography: _____
 (Hilly) (Flat) (Level)

(4) Purpose of Well: DOMESTIC
 (Domestic Irrigation
 Municipal, Industrial, Other)

Description & Color of Materials Sand, Clay, Red Clay, Shell, etc.	Thick- ness Feet	Depth Feet
CLAY	12	12'
SAND	73	85'
GRAVEL	52	137
GUMBO	78	215
SAND	81	296
GUMBO	42	338
SAND	83	421
GUMBO	40	461
SAND W/HARD ROCKS	240	701
GUMBO	207	908
SAND W/ROCK	244	1152
GUMBO	125	1277
SHALE	156	1433
GREEN SAND W/ROCKS	104	1537
SHALE	130	1667
BROWN SAND W/ROCKS	52	1719
SHALE	155	1874
WHITE SAND	60	1934
SHALE	19	1953

Information upon completion of well:

(1) Diameter 3 inches.

(2) Total Depth 1953 feet.

(3) Water Level WELL FLOWS feet below top of ground.


(4) Cased to 1923, Size 3" 1173' 2" 777'

(5) Screen: Size 2", Length 30'

(6) Were any formations sealed against pollution?
 _____ yes, _____ no.

If YES depth of formation _____
 Why _____

Drillers Remarks: 27' LAP OF 2" IN 3" PIPE. WELL FLOWS - 60 G.P.M. WITH 25# PRESSURE.

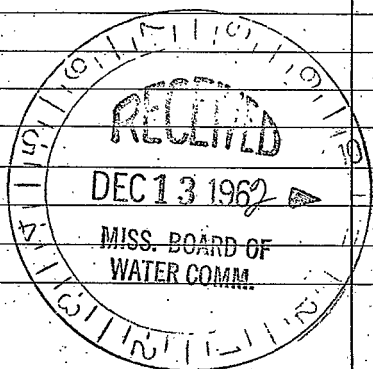

(Use Back Side)

Well No.

