

SUNF.

WATER WELL DRILLERS LOG

M 28

Date: MAY 11, 1964, Driller: DELTA DRILLING CO. County: SUNFLOWER

5-11-64

(Name)

(1) Owner of Land: DORIS W. DODD
(Name)

RTE. 2, INDIANOLA, MISS.
(Address)

(2) Location: SW 1/4, SE 1/4, Sec. 20 T28R5-W

 miles of
(distance) (direction) (Nearest Town)

(3) Topography:
(Hilly) (Flat) (Level)

(4) Purpose of Well: DOMESTIC
(Domestic Irrigation
Municipal, Industrial, Other)

Description & Color of Materials Sand, Clay, Red Clay, Shell, etc.	Thick- ness Feet	Depth Feet
SAND	92	92
GRAVEL	76	168
SAND	252	420
GUMBO	50	470
SHALE	32	502
SAND	30	532
GUMBO	48	580
SHALE	63	643
SAND	41	684
GUMBO	96	780
SAND	72	852
SHALE	60	912
SAND	62	974
SHALE	64	1038
SAND	25	1063
GUMBO	117	1180
GREEN SAND w/ROCKS	46	1226
SHALE	80	1306
GREEN SAND w/ROCKS	52	1358
SHALE w/10" ROCK	38	1396
GREEN SAND w/ROCKS	66	1462
SHALE	104	1566
GREEN SAND	78	1644
SHALE	130	1774
SAND	52	1826
SHALE	50	1876

Information upon completion of well:

(1) Diameter: 8 inches.

(2) Total Depth: 1876 feet.

(3) Water Level: FLOWS - feet below top of ground.

(4) Cased to: 1772, Size: 7 1/4" - 2"
10 9/16" - 3"
18 06

(5) Screen: Size 2", Length 20'

(6) Were any formations sealed against pollution?


 yes, no.

If YES depth of formation

Why

Drillers Remarks: 84' - 2" TAIL PIPE
ON BOTTOM END OF WELL
WELL FLOWS - APPROX - 65 G.P.M.

34' LAP OF 2" IN 3" PIPE
PRESSURE - 20#

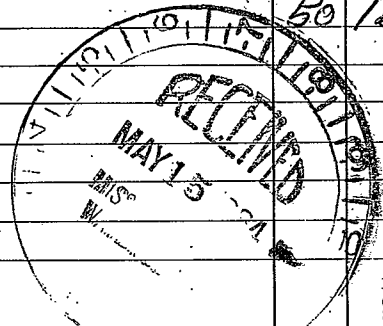

(Use Back Side)

Well No.

