

J M 29
9-30-63

WATER WELL DRILLERS LOG

Date: SEPT. 30, 1963, Driller: DELTA DRILLING Co. County SUNFLOWER
(Name)

(1) Owner of Land: ETHEL LYON + W.C. HENDON
(Name)

R.F.D. - SHAW, MISS
(Address)

(2) Location: NE 1/4, NW 1/4, Sec. 32 T. 19 S. R. 5 W.
New Holly Miss
miles _____ of _____
(distance) (direction) (Nearest Town)

(3) Topography: _____
(Hilly) (Flat) (Level)

(4) Purpose of Well: DOMESTIC
(Domestic Irrigation, Municipal, Industrial, Other)

Information upon completion of well:


- (1) Diameter _____ inches.
- (2) Total Depth 1883 feet.
- (3) Water Level WELL FLOWS feet below top of ground. 1175' - 3"
- (4) Cased to 1863, Size 735' - 8"
- (5) Screen: Size 2", Length 20
- (6) Were any formations sealed against pollution?
_____ yes, _____ no.

If YES depth of formation _____

Why _____

Drillers Remarks: 27' LAP OF 2"
IN 3" PIPE.

Description & Color of Materials Sand, Clay, Red Clay, Shell, etc.	Thick- ness Feet	Depth Feet
TOP SOIL + GUMBO	22	22
SAND	66	88
GRAVEL	68	156
GUMBO	155	311
SHALE	251	562
SAND	85	647
SHALE	88	735
GUMBO	53	788
SHALE	32	820
SAND	34	854
SHALE	114	968
SAND	70	1038
GUMBO	20	1058
SHALE	32	1090
GUMBO	93	1183
SHALE W/ROCKS.	36	1219
GREEN SAND W/ROCKS-	22	1241
GUMBO W/ROCKS.	46	1287
GREEN SAND W/ROCKS-	78	1365
HARD GUMBO	84	1449
SAND W/ROCKS	124	1573
SHALE	26	1599
GUMBO	78	1677
SHALE	82	1765
SAND	34	1799
WHITE SAND	84	1883

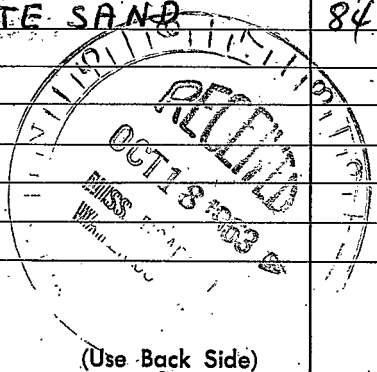

(Use Back Side)

Well No.

