

SUNFLOWER
M 30
3-29-75

MISSISSIPPI
 BOARD OF WATER COMMISSIONERS
 416 North State Street
 Jackson, Mississippi 39201

CODED

WATER WELL DRILLERS LOG


March 29, 19 75 Singer-Layne Central Div. Sunflower
 date well completed firm name county well located

LANDOWNER:	description of fomations encountered	from	to
Phillip Fratesi Indianola, MS (mailing address)			
	Sandy Clay	3	33
	Sand Pea Gravel & Large Gravel	33	112
WELL LOCATION: sec. 30 T 19 N R 5 W 1 1/2 miles northwest of Indianola (distance) (direction) (nearest town)			
WELL PURPOSE: irrigation (home, irrigation, municipal, industrial)			
WELL COMPLETION DATA:			
(1) diameter (inches) 12"			
(2) total depth (feet) 112'			
(3) static water level (feet) 14' below top of ground.			
(4) casing steel 72' (material) (depth) 12" (size) if telescope see back.			
(5) screen 40' 72' (length) (depth to top) 12" (size) steel (material)			
(6) pump 1800 (HP) 1800 (yield gpm) engine (type power)			
(7) electric log no (yes or no)			
(organization running log)			
(8) how well bottom plugged with plate			
DRILLERS REMARKS:			

RECEIVED
 MAY 19 1975
 MISS. RD. OF WATER COMMISSIONERS

If well telescopes please sketch and show depths.

GROUND LEVEL

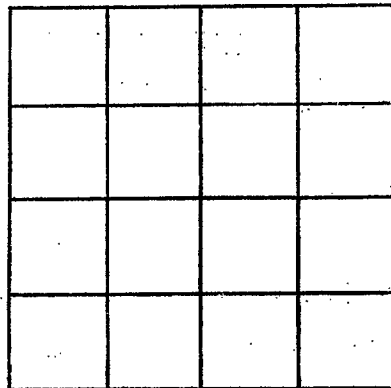

SECTION _____

Please indicate well location X.

ADDITIONAL INFORMATION

If more than one screen, show locations of each on sketch.