

SUNFLOWER
M31
11-10-77

MISSISSIPPI
BOARD OF WATER COMMISSIONERS CODED

416 North State Street
Jackson, Mississippi 39201

WATER WELL DRILLERS LOG

11-10 1977 Dyer, Well # 122 Sunflower
date well completed firm name county well located

LANDOWNER: Holly Ridge P.H. Co.
Rural Route
Indianole, Miss.
(mailing address)

WELL LOCATION:
sec. 20 T. 19 N. R. 5 E
S W
Seven miles NW of Indianole
(distance) (direction) (nearest town)

WELL PURPOSE: Irrigation
(home, irrigation, municipal, industrial)

WELL COMPLETION DATA:
(1) diameter (inches) 16"
(2) total depth (feet) 120'
(3) static water level (feet) 18' below top of ground.
(4) casing Steel, 30' (depth), 16" (size) if telescope see back.
(5) screen 40' (length), 80' (depth to top), 16" (size), Steel (material)
(6) pump 40 (HP), 2200 (yield gpm), DIESEL (type power)
(7) electric log No (yes or no)
(organization running log)
(8) how well bottom plugged Date

description of formations encountered	from	to
SAND	0	13
SAND	14	23
SAND	24	33
SAND + GRAVEL	34	43
SAND + GRAVEL	44	53
SAND + GRAVEL	54	63
SAND + GRAVEL	64	73
SAND + GRAVEL	74	83
SAND + GRAVEL	84	93
SAND + GRAVEL	94	103
SAND + GRAVEL	104	113
SAND + CODED	114	120
Bottom - 121' Clay		

RECEIVED
NOV 17 1977

MISS. BD. OF WATER COMM

DRILLERS REMARKS:

If well telescopes please sketch and show depths.

GROUND LEVEL


Casing

80' →

SCREEN
(40')

20' →

20' →

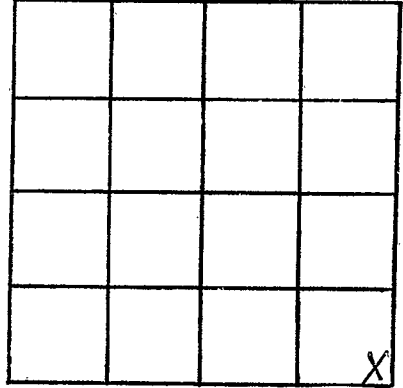

SECTION 20

Please indicate well location X.

ADDITIONAL INFORMATION

Lined area for additional information.

If more than one screen, show locations of each on sketch.