

SUNFLOWER
M 35
12/14/78

MISSISSIPPI
BOARD OF WATER COMMISSIONERS
416 North State Street
Jackson, Mississippi 39201

CODED

WATER WELL DRILLERS LOG

December 14, 1978 DER WELL + Irrigation Sunflower
date well completed firm name county well located

LANDOWNER: <u>BURKE FISHER</u>	description of formations encountered	from	to
<u>Indianola, Miss.</u> (mailing address)	<u>Clay</u>	<u>0</u>	<u>30</u>
WELL LOCATION: sec. <u>33</u> T. <u>19</u> N. R. <u>5</u> E	<u>FINE SAND</u>	<u>30</u>	<u>43</u>
<u>4</u> miles <u>West</u> of <u>Indianola</u> (distance) (direction) (nearest town)	<u>SAND</u>	<u>43</u>	<u>48</u>
WELL PURPOSE: <u>Irrigation</u> (home, irrigation, municipal, industrial)	<u>SAND + GRAVEL</u>	<u>48</u>	<u>90</u>
WELL COMPLETION DATA: (1) diameter (inches) <u>12"</u>	<u>SAND</u>	<u>90</u>	<u>113</u>
(2) total depth (feet) <u>113'</u>	<u>Bottom</u>		<u>113'</u>
(3) static water level (feet) <u>18'</u> below top of ground.			
(4) casing <u>Steel</u> <u>73'</u> (material) (depth)			
<u>16"</u> if telescope see back. (size)			
(5) screen <u>40'</u> <u>73'</u> (length) (depth to top)			
<u>16"</u> <u>Steel</u> (size) (material)			
(6) pump <u>40</u> <u>2000</u> (HP) (yield gpm)			
<u>Diesel</u> (type power)			
(7) electric log <u>NO</u> (yes or no)			
(8) how well bottom plugged <u>Plate</u>			
DRILLERS REMARKS:			


Miss. Board of Water Comm.

FEB 6 1979

RECEIVED

If well telescopes please sketch and show depths.

GROUND LEVEL

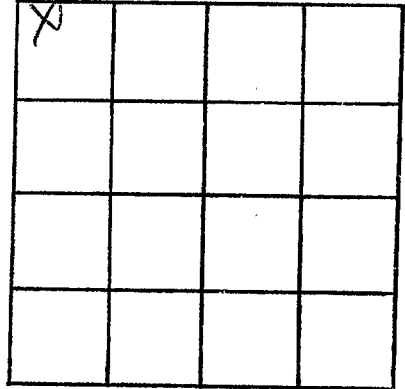

SECTION

33

Please indicate well location X.

ADDITIONAL INFORMATION

If more than one screen, show locations of each on sketch.