

SUNFLOWER
M 37
7-11-79

MISSISSIPPI
BOARD OF WATER COMMISSIONERS
416 North State Street
Jackson, Mississippi 39201

CODED

WATER WELL DRILLERS LOG

SUNFLOWER
LEFL

7/11 1979 DYER WELL # 1 RR
date well completed firm name county well located

LANDOWNER:
W. W. GRESHAM III
INDIANOLA -
(mailing address)

description of formations encountered	from	to
CLAY	0	28
FINE SAND	28	45
SAND	45	58
SAND & GRAVEL	58	110

WELL LOCATION:
sec. 21 T. 19 N R. 5 E
3 1/2 miles NW of INDIANOLA
(distance) (direction) (nearest town)

WELL PURPOSE:
(home, irrigation, municipal, industrial)

- WELL COMPLETION DATA:
- (1) diameter (inches) 16
 - (2) total depth (feet) 110
 - (3) static water level (feet) 19 below above top of ground.
 - (4) casing STEEL, 70 (material) (depth)
16 if telescope see back. (size)
 - (5) screen 40 70 (length) (depth to top)
16 STEEL (size) (material)
 - (6) pump 60 (HP) (yield gpm)
DIESEL (type power)
 - (7) electric log No (yes or no)
 - (organization running log)
 - (8) how well bottom plugged PLATE

DRILLERS REMARKS:


DEPT. OF NATURAL RESOURCES
BUREAU OF LAND & WATER RESOURCES

NOV 18 1979

RECEIVED

If well telescopes please sketch and show depths.

GROUND LEVEL

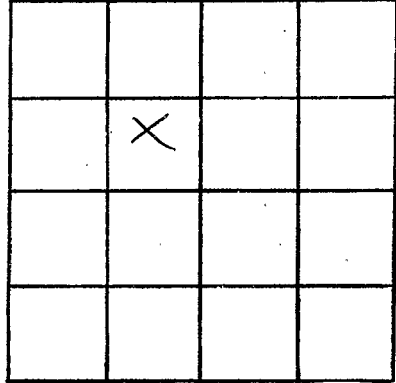

SECTION 2/1

Please indicate well location X.

ADDITIONAL INFORMATION

Lined area for additional information.

If more than one screen, show locations of each on sketch.